

21-00748.00



FALL CREEK REGIONAL WASTE DISTRICT

9378 S. 650 West PO Box 59
Pendleton, IN 46064-0059 778-7544

APPLICATION FOR SEWER PERMIT

Nº 2640

Date 10/23/98

Permit Void 90 days from Date of Issuance

Owner Name Tim Green

Property Address 315 Manifold

Lot # _____ P.O. Box _____

Town Lagalls, IN Zip Code 46048

Phone _____ City Water _____ Well _____

\$ 400 Tap on Fee Paid 4/30/99

\$ 2485 Capacity fee paid 4/30/99

Application is hereby made for connection to the Fall Creek Regional Waste District Sewer System for the above listed property - Permit Type: Residential _____, Commercial ☒, Industrial _____, or Governmental/Institutional _____. User Information _____.

All workmanship and materials shall conform to the standards of the District Ordinance as described in Ordinance 84-2 and 84-3 as amended. Acceptance and approval must be made by the District inspector or his duly authorized representative before backfilling and final connection is made to the main sewer lines. Any violation of applicable regulations will cause all lines and appurtenances in violation to be removed and replaced at the owners expense.

The Fall Creek Regional Waste District is responsible for the inspection, approval of materials, and installation techniques only. All costs for materials and installation and any liabilities resulting from same is the sole responsibility of the property owner.

I have read and fully understand the above provisions and agree to comply by said provisions.

APPLICANT(S) SIGNATURE


INSPECTOR TIM

Date inspected 10-24-98 Approved ☒ Rejected _____

Reason for rejection _____

Date reinspected _____ Approved _____ Rejected _____

Notes:
Size Pipe 6"
Type Pipe SDR 35
Basement Yes ☐ No ☒
Sump Pump Yes ☐ No ☒
Downspout to Ground Yes ☒ No ☐
Septic Tank Pumped & filled Yes ☐ No ☐
Contractor SELF
Special Conditions _____
Existing Home ☒
New Construction _____

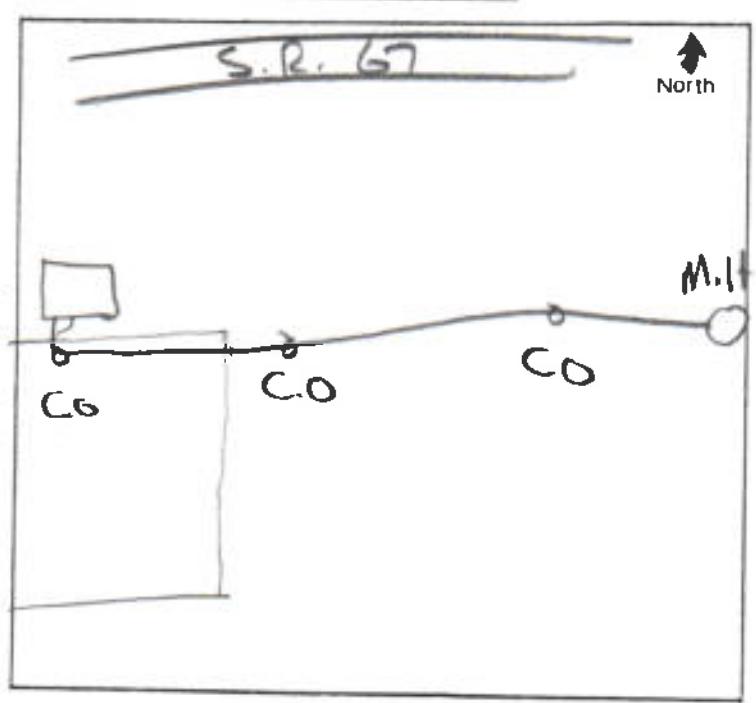

DEBORAH K. GREEN 11-98
TIMOTHY E. GREEN
317-485-7069
313 N. MANIFOLD
INGALLS, IN. 46048-9734

DATE

4/28/99

1045

71-553/749
BRANCH 1

PAY TO THE
ORDER OF

Fall Creek Regional Waste

\$ 2885.00

Two Thousand Eight Hundred Eighty five & 00/100

DOLLARS  Security watermark
included
See back for details.



Pendleton Banking
Company
Member FDIC

FOR

1:

Deborah Green

1045

© HAMILTON