

Gidw.

PROJECT

Phase II

SHEET

OF

SUBJECT

DATE

6-1-18

JOB NO


4447

BY

Atlas

315 S. Pearl

N →

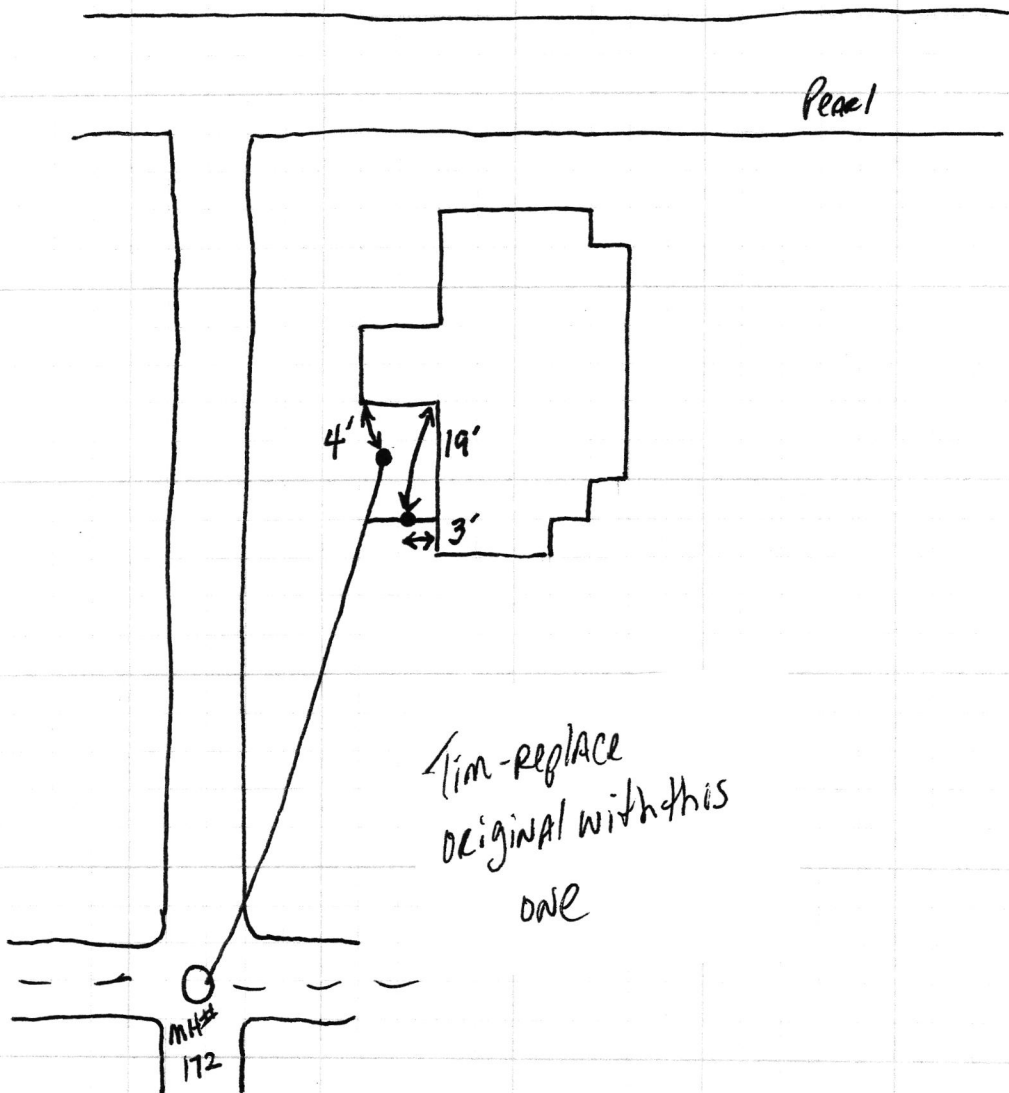

315 S Pearl

SPR Phase II

6.2.18



Sht. Phase II

8.15.18



Gidw.

PROJECT Phase II SHEET _____ OF _____

SUBJECT _____ DATE 6-1-18

JOB NO. 4447

BY _____

315 S. Pearl

N →

