

Gidw.

PROJECT Phase II

SHEET _____ OF _____


SUBJECT _____

DATE 1-29-18

JOB NO. 4447

BY Atlas

315 S. West

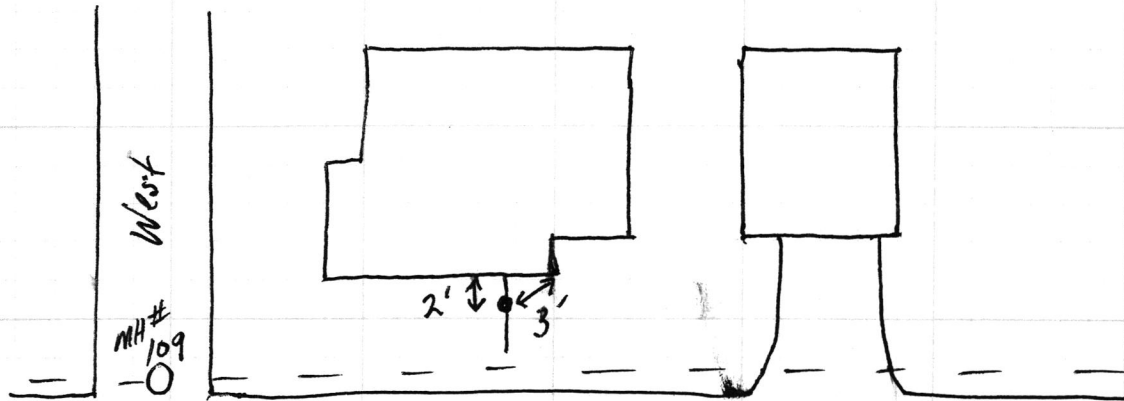

315 ~~to File~~
West ST

SNP Phase II

