

Gidw.


PROJECT Phase II SHEET _____ OF _____

SUBJECT _____ DATE 4-5-18

JOB NO. 4447

BY AHAS

315 W. High

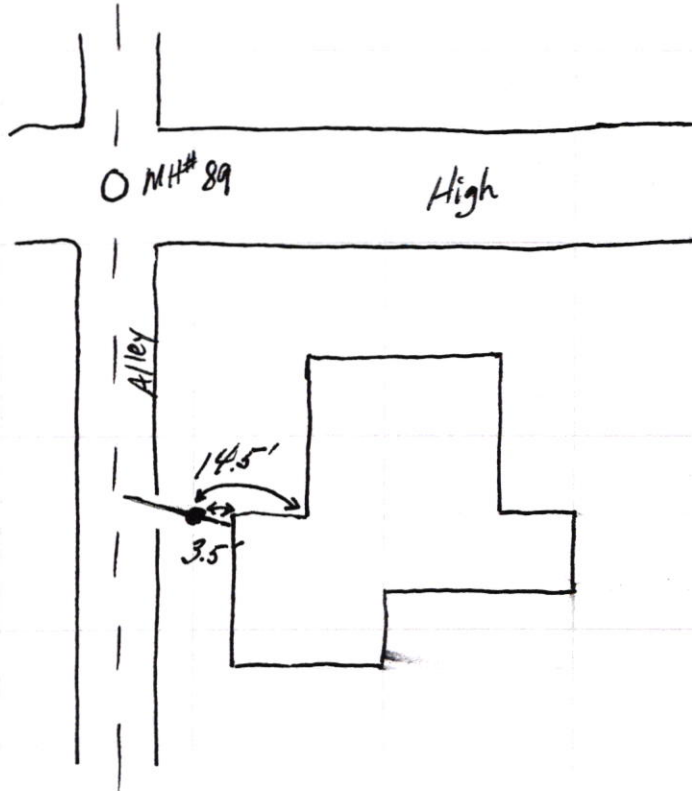

315 W High

SRF
Phase II

4.11.18

