

Side




PROJECT Phase II SHEET _____ OF _____

SUBJECT _____ DATE 2-2-18

JOB NO. 4447

BY Atlas

315 W. Taylor

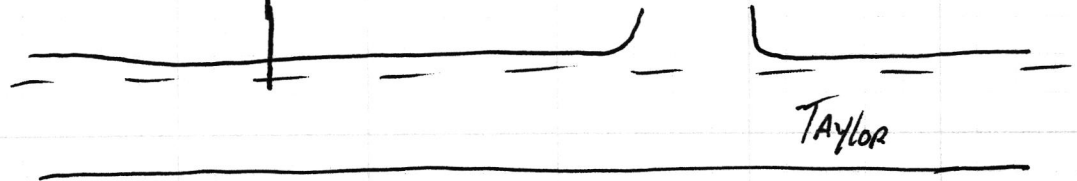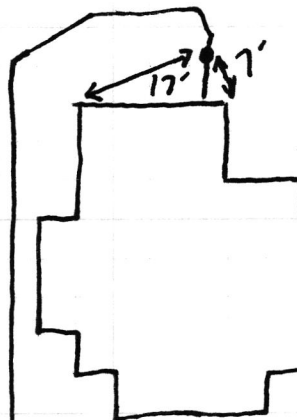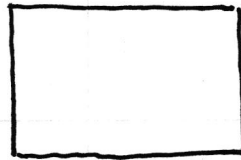

315 W Taylor SRF Phase II

