


add order  
or file

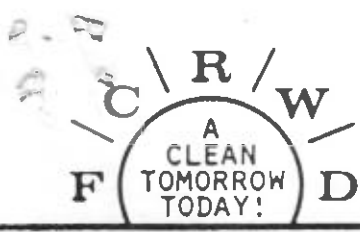

FALL CREEK REGIONAL WASTE DISTRICT

9378 S. 650 West PO Box 59  
Pendleton, IN 46064-0059 778-7544 22-16905.00

APPLICATION FOR SEWER PERMIT

Nº 2461

Date 7-1-97

Permit Void 90 days from Date of Issuance

Owner Name Ivan Sizemore (Gehring Construction)

Property Address 316 Ladino Ln.

Lot # 31 P.O. Box

Town Pendleton, IN Zip Code 46064

Phone (317) 485-4486 City Water Well

\$ 2556.00 Tap on Fee Paid

\$ Inspection fee paid

Application is hereby made for connection to the Fall Creek Regional Waste District Sewer System for the above listed property - Permit Type: Residential, Commercial, Industrial, or Governmental/Institutional. User Information

All workmanship and materials shall conform to the standards of the District Ordinance as described in Ordinance 84-2 and 84-3 as amended. Acceptance and approval must be made by the District inspector or his duly authorized representative before backfilling and final connection is made to the main sewer lines. Any violation of applicable regulations will cause all lines and appurtenances in violation to be removed and replaced at the owners expense.

The Fall Creek Regional Waste District is responsible for the inspection, approval of materials, and installation techniques only. All costs for materials and installation and any liabilities resulting from same is the sole responsibility of the property owner.

I have read and fully understand the above provisions and agree to comply by said provisions.

Melanie Gehring APPLICANT(SIGNATURE)

\*\*\*\*\*


INSPECTOR Don

Date inspected 11-97 Approved Rejected

Reason for rejection

Date reinspected Approved Rejected

Notes:  
Size Pipe 4"  
Type Pipe PVC  
Basement Yes No  
Sump Pump Yes No  
Downspout to Ground Yes No  
Septic Tank Pumped & filled Yes No  
Contractor Brian Brown Etc.  
Special Conditions  
Existing Home  
New Construction

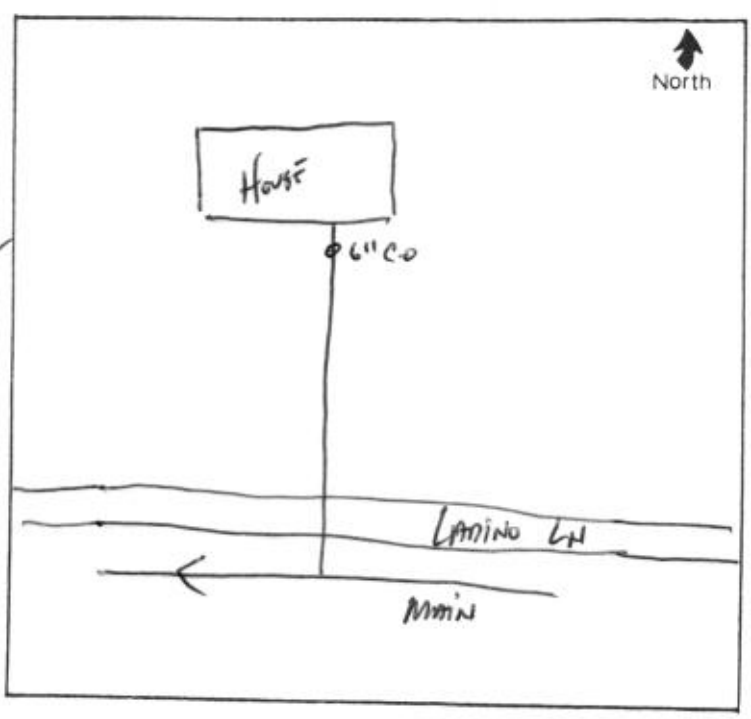

1944  
1945

1946 1947 1948 1949 1950

1951 1952 1953 1954 1955

1956

1957

(continued from page 1)

1958


1959  
1960  
1961

1962 1963 1964 1965 1966

1967

1968

1969 1970 1971 1972 1973

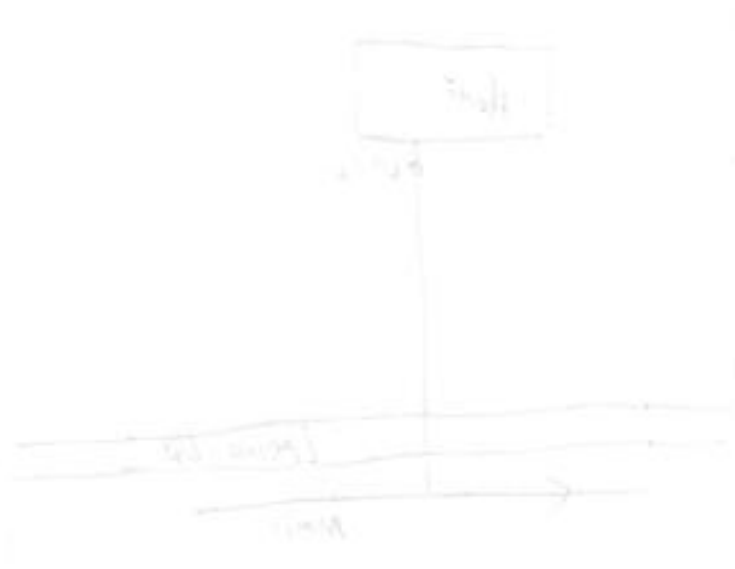

GEHRING CONSTRUCTION

PH. 317-485-4486

10244 N. 50 W.

FORTVILLE, IN 46040-9328

71-367/749

99074583

1143

DATE 7-11-97

PAY TO THE  
ORDER OF

Fall Creek Waste Management \$ 2556.00  
Twenty five fifty six and 00/100

DOLLARS  Security features  
included.  
Details on back.



Greenfield Banking Company

FORTVILLE OFFICE • FORTVILLE, INDIANA 46040

MEMO Sizemore

Chi Gehrig

MP

⑆074903670⑆ 99074583⑆ 1143

FINE LINE