

Gidw.


PROJECT Phase II SHEET _____ OF _____

SUBJECT _____ DATE 6-22-18

JOB NO. 4447

BY AHAS

316 Laurel St.

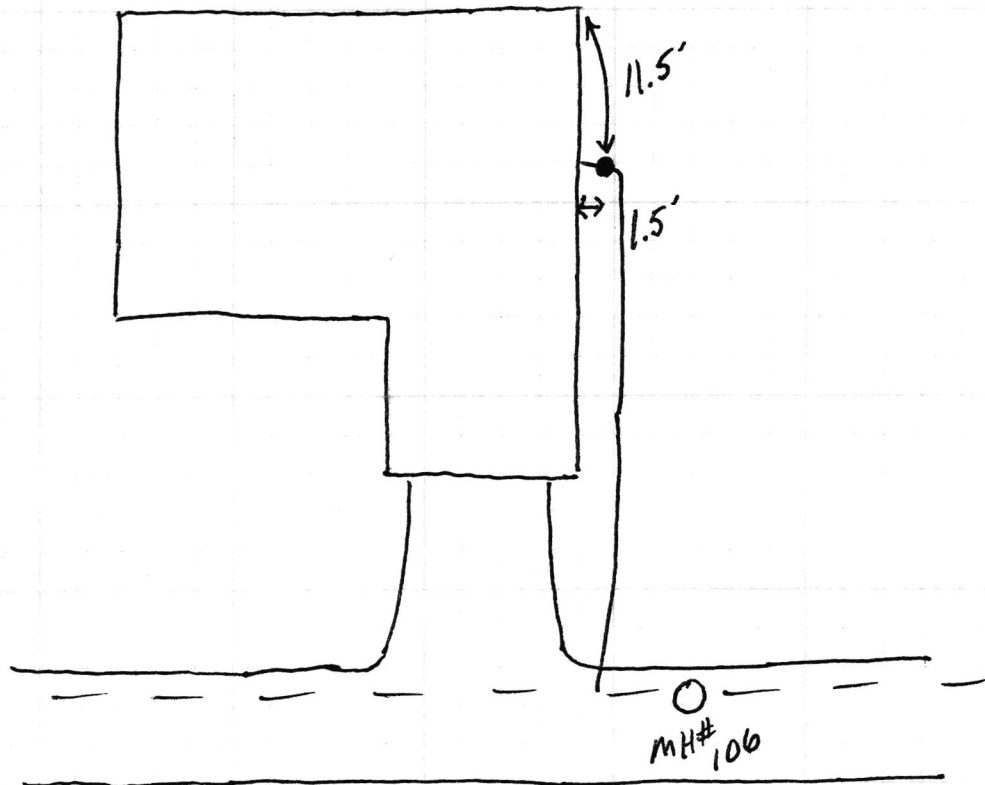

310 Laurel

SRF Phase II

6.25.18

