


Gidw.

PROJECT Phase II SHEET _____ OF _____
SUBJECT _____ DATE 7-23-18
JOB NO. 4447
BY Atlas

316 S. Pearl

← N

Pearl

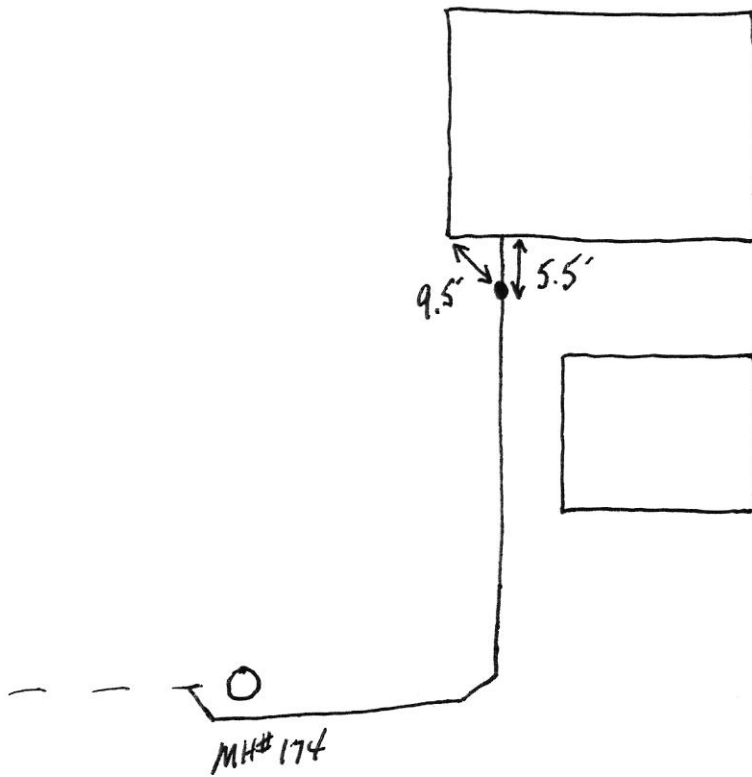

310 Pearl

SRF Phase II

7.30.18

