

Gidw.

PROJECT

Phase II

SHEET _____ OF _____


SUBJECT

DATE 5-11-18

JOB NO. 4447

BY Atlas

316 S. Pendleton

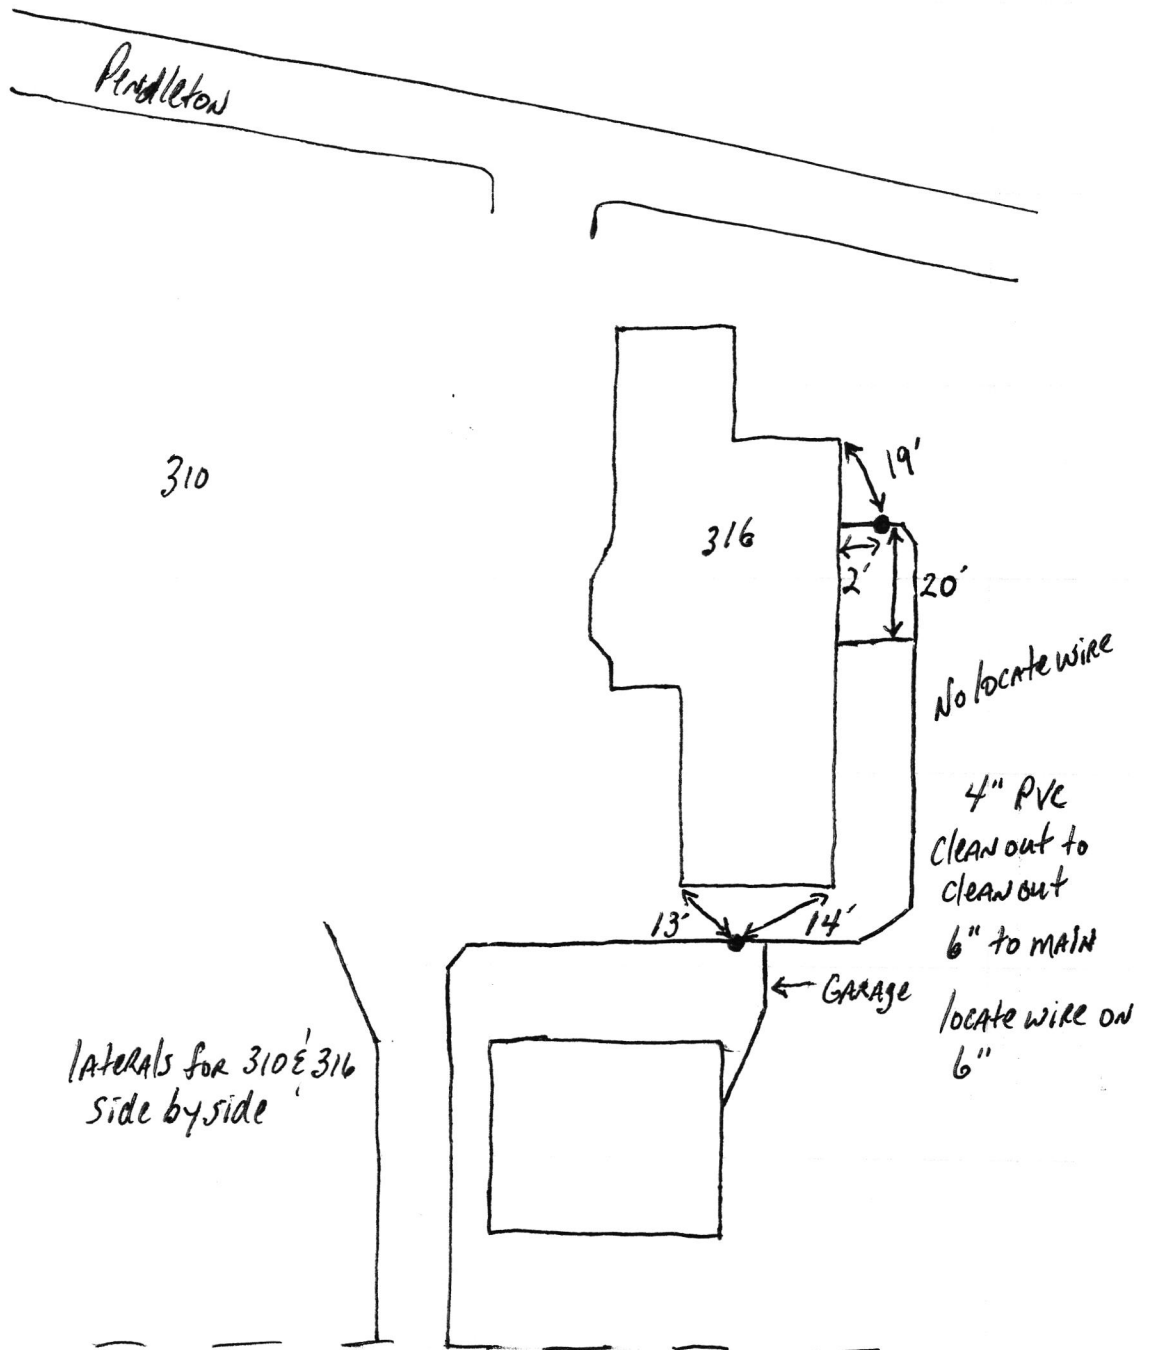

○
MH # 146C



310 S Pendleton

SRF Phase II

S-14-18

316 S Pendleton

SRE Phase II

5-14-12

