

Gidw.


PROJECT Phase II SHEET _____ OF _____

SUBJECT _____ DATE 3-28-18

JOB NO. 4447

BY Atlas

316 W. Taylor

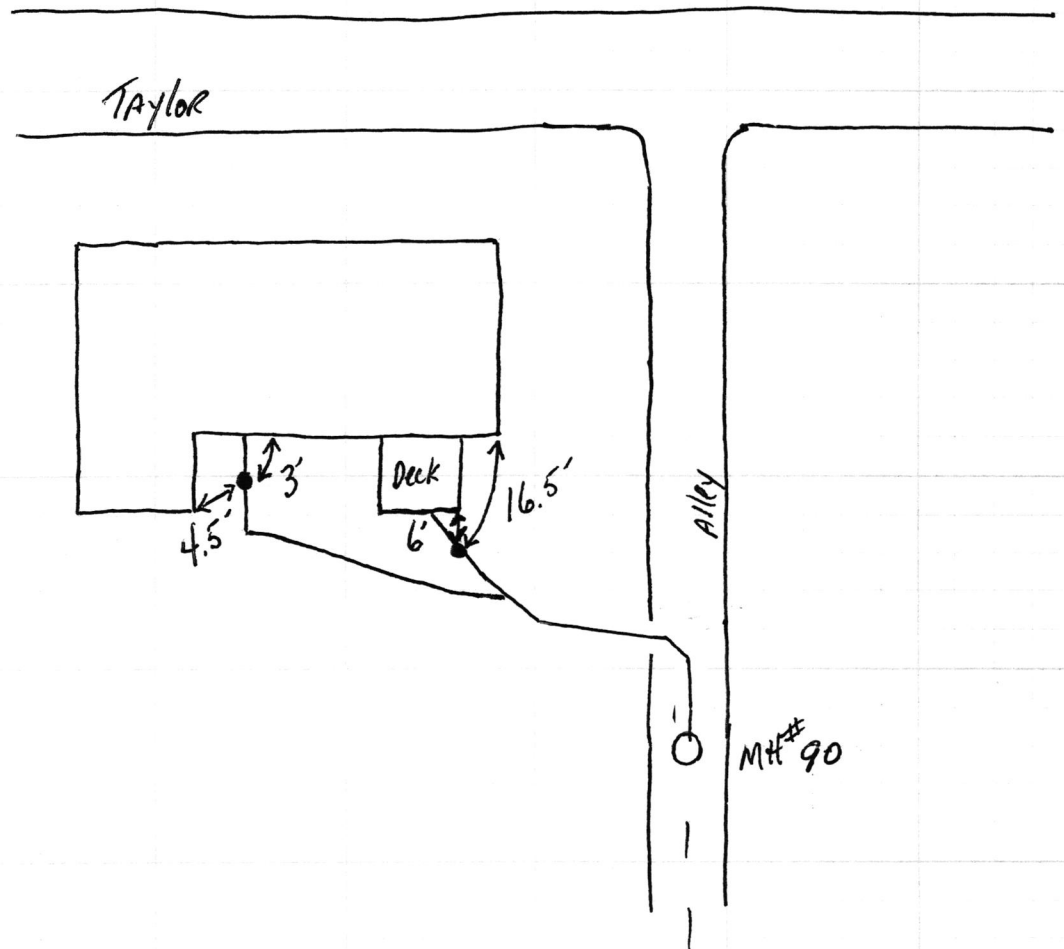

316 W Taylor SRP Phase II



316 W Taylor

SRF Phase II

