

Gidw.

PROJECT

Phase II

SHEET

OF

SUBJECT

DATE


7-10-18

JOB NO.

4447

BY

AHAS

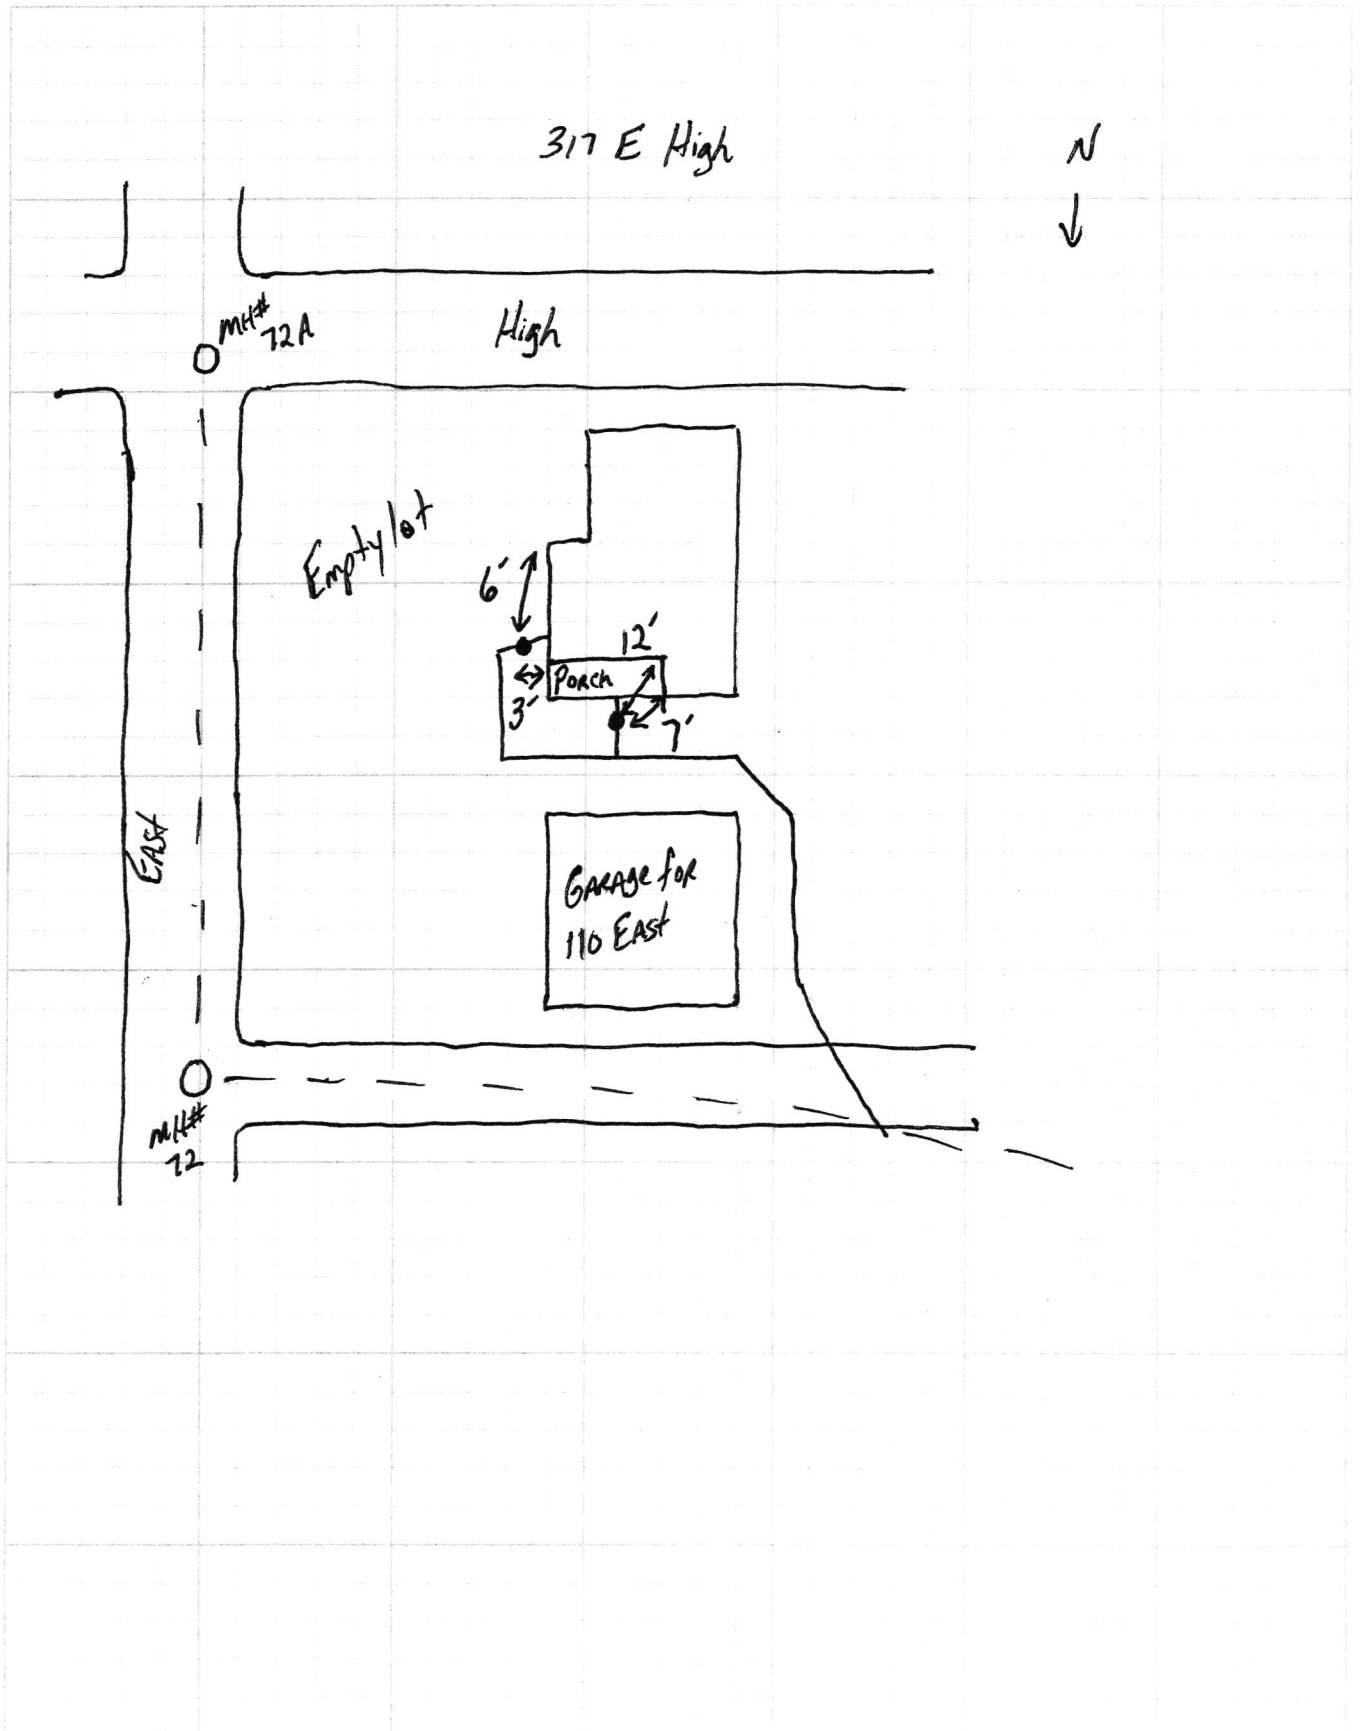

511 2 High

Sgt Phase II

7.11.18



01.00001

off track 4

7.11.18

