


Gidw.

PROJECT Phase II SHEET _____ OF _____
SUBJECT _____ DATE 6-15-18
JOB NO. 4447
BY Atlas

317 E. MADISON

↑
N

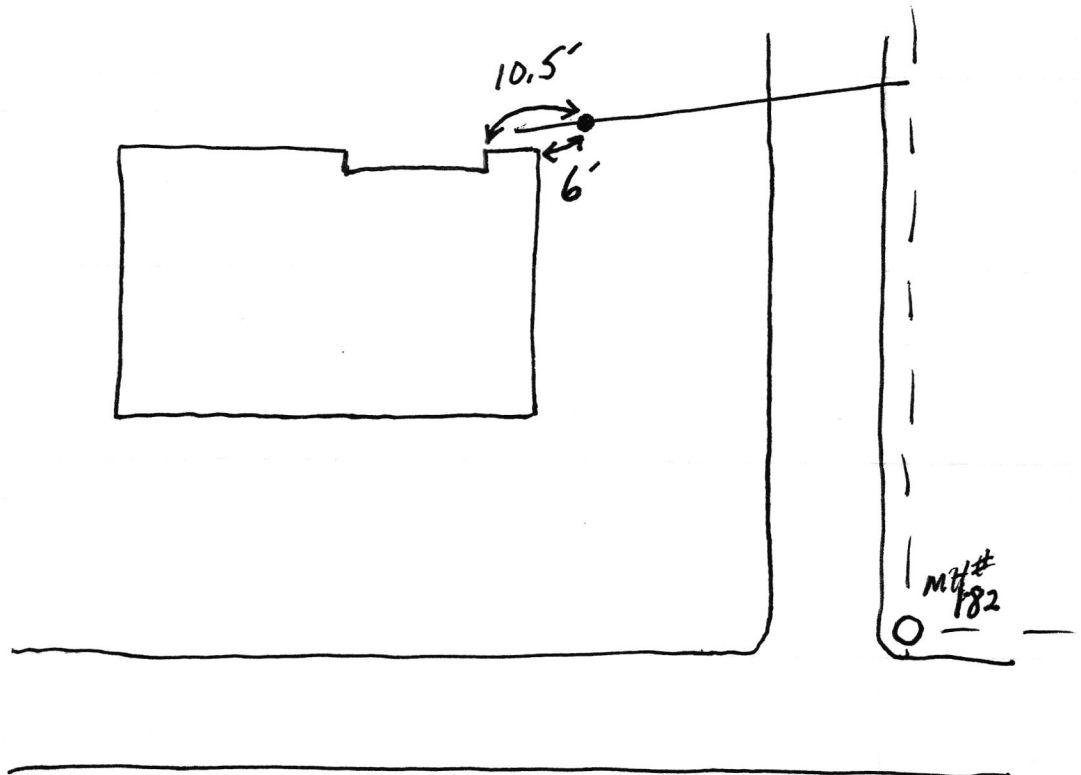

317 Madison

SRF Phase II

6.19.18

