




PROJECT Phase II SHEET _____ OF _____

SUBJECT _____ DATE 6-4-18

JOB NO. 4447

BY Atlas

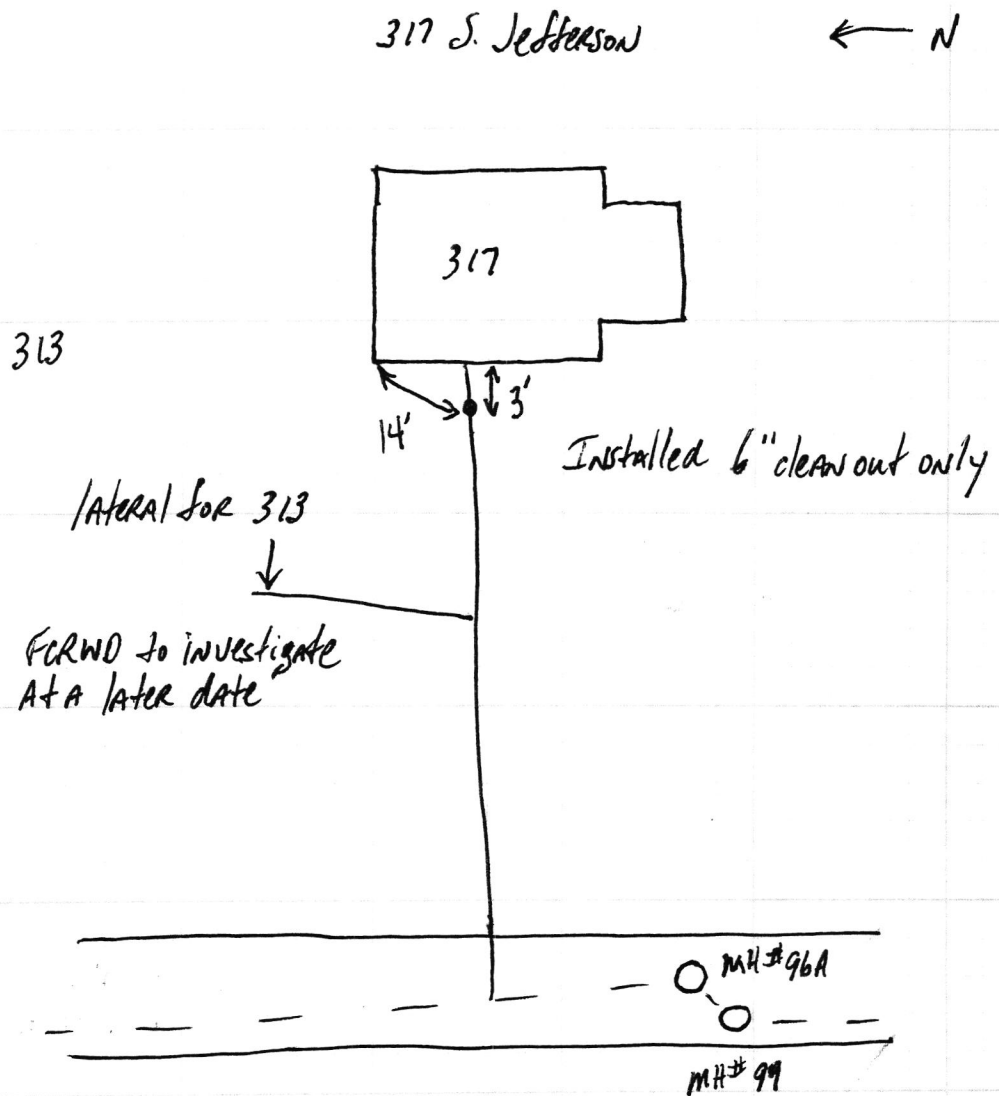

37 S Jefferson

SPT Phase II

6.11.18

