



# FALL CREEK REGIONAL WASTE DISTRICT

9378 S. 650 West PO Box 59  
Pendleton, IN 46064-0059 778-7544

10-24531.00

add order  
on file

## APPLICATION FOR SEWER PERMIT

No 2480

Date 10/2/97

Permit Void 90 days from Date of Issuance

Owner Name Pendleton Studio

Property Address 3187 W Angel Road

Lot # \_\_\_\_\_ P.O. Box 222

Town Pendleton, IN Zip Code 46064

Phone \_\_\_\_\_ City Water \_\_\_\_\_ Well ☒

\$ 400.00 Tap on Fee Paid 4857.34 pd. 4/9/98

\$ \_\_\_\_\_ Inspection fee paid

Application is hereby made for connection to the Fall Creek Regional Waste District Sewer System for the above listed property - Permit Type: Residential ☒, Commercial \_\_\_\_\_, Industrial \_\_\_\_\_, or Governmental/Institutional \_\_\_\_\_. User Information \_\_\_\_\_.

All workmanship and materials shall conform to the standards of the District Ordinance as described in Ordinance 84-2 and 84-3 as amended. Acceptance and approval must be made by the District inspector or his duly authorized representative before backfilling and final connection is made to the main sewer lines. Any violation of applicable regulations will cause all lines and appurtenances in violation to be removed and replaced at the owners expense.

The Fall Creek Regional Waste District is responsible for the inspection, approval of materials, and installation techniques only. All costs for materials and installation and any liabilities resulting from same is the sole responsibility of the property owner.

I have read and fully understand the above provisions and agree to comply by said provisions.

APPLICANT(S) SIGNATURE

INSPECTOR B

Date inspected 10-2-97 Approved ☒ Rejected \_\_\_\_\_

Reason for rejection \_\_\_\_\_

Date reinspected \_\_\_\_\_ Approved \_\_\_\_\_ Rejected \_\_\_\_\_

Notes:

Size Pipe 6" PVC

Type Pipe PVC

Basement Yes \_\_\_\_\_ No ☒

Sump Pump Yes \_\_\_\_\_ No ☒

Downspout to Ground Yes ☒ No \_\_\_\_\_


Septic Tank Pumped & filled Yes ☒ No \_\_\_\_\_

Contractor MJM

Special Conditions \_\_\_\_\_

Existing Home ☒

New Construction \_\_\_\_\_

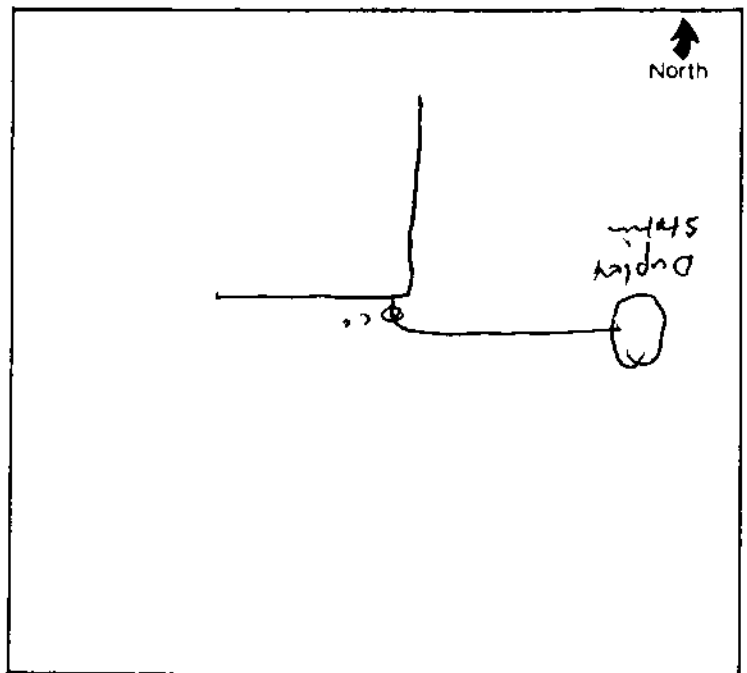

P-tm  
Studio

\$ 400 TA  
6,460 cap, fee  
(1900 x 3.4)

\$ 1,746<sup>20</sup> Pro. actual  
Consts  
cost

\$	8,606	<sup>20</sup>	
-	3,348	<sup>86</sup>	3 yr revenue credit
\$	5,257	<sup>34</sup>	

\$ 4857.34