


Grid

PROJECT Phase II SHEET _____ OF _____

SUBJECT _____ DATE 7-6-18

JOB NO 4447

BY Atlas

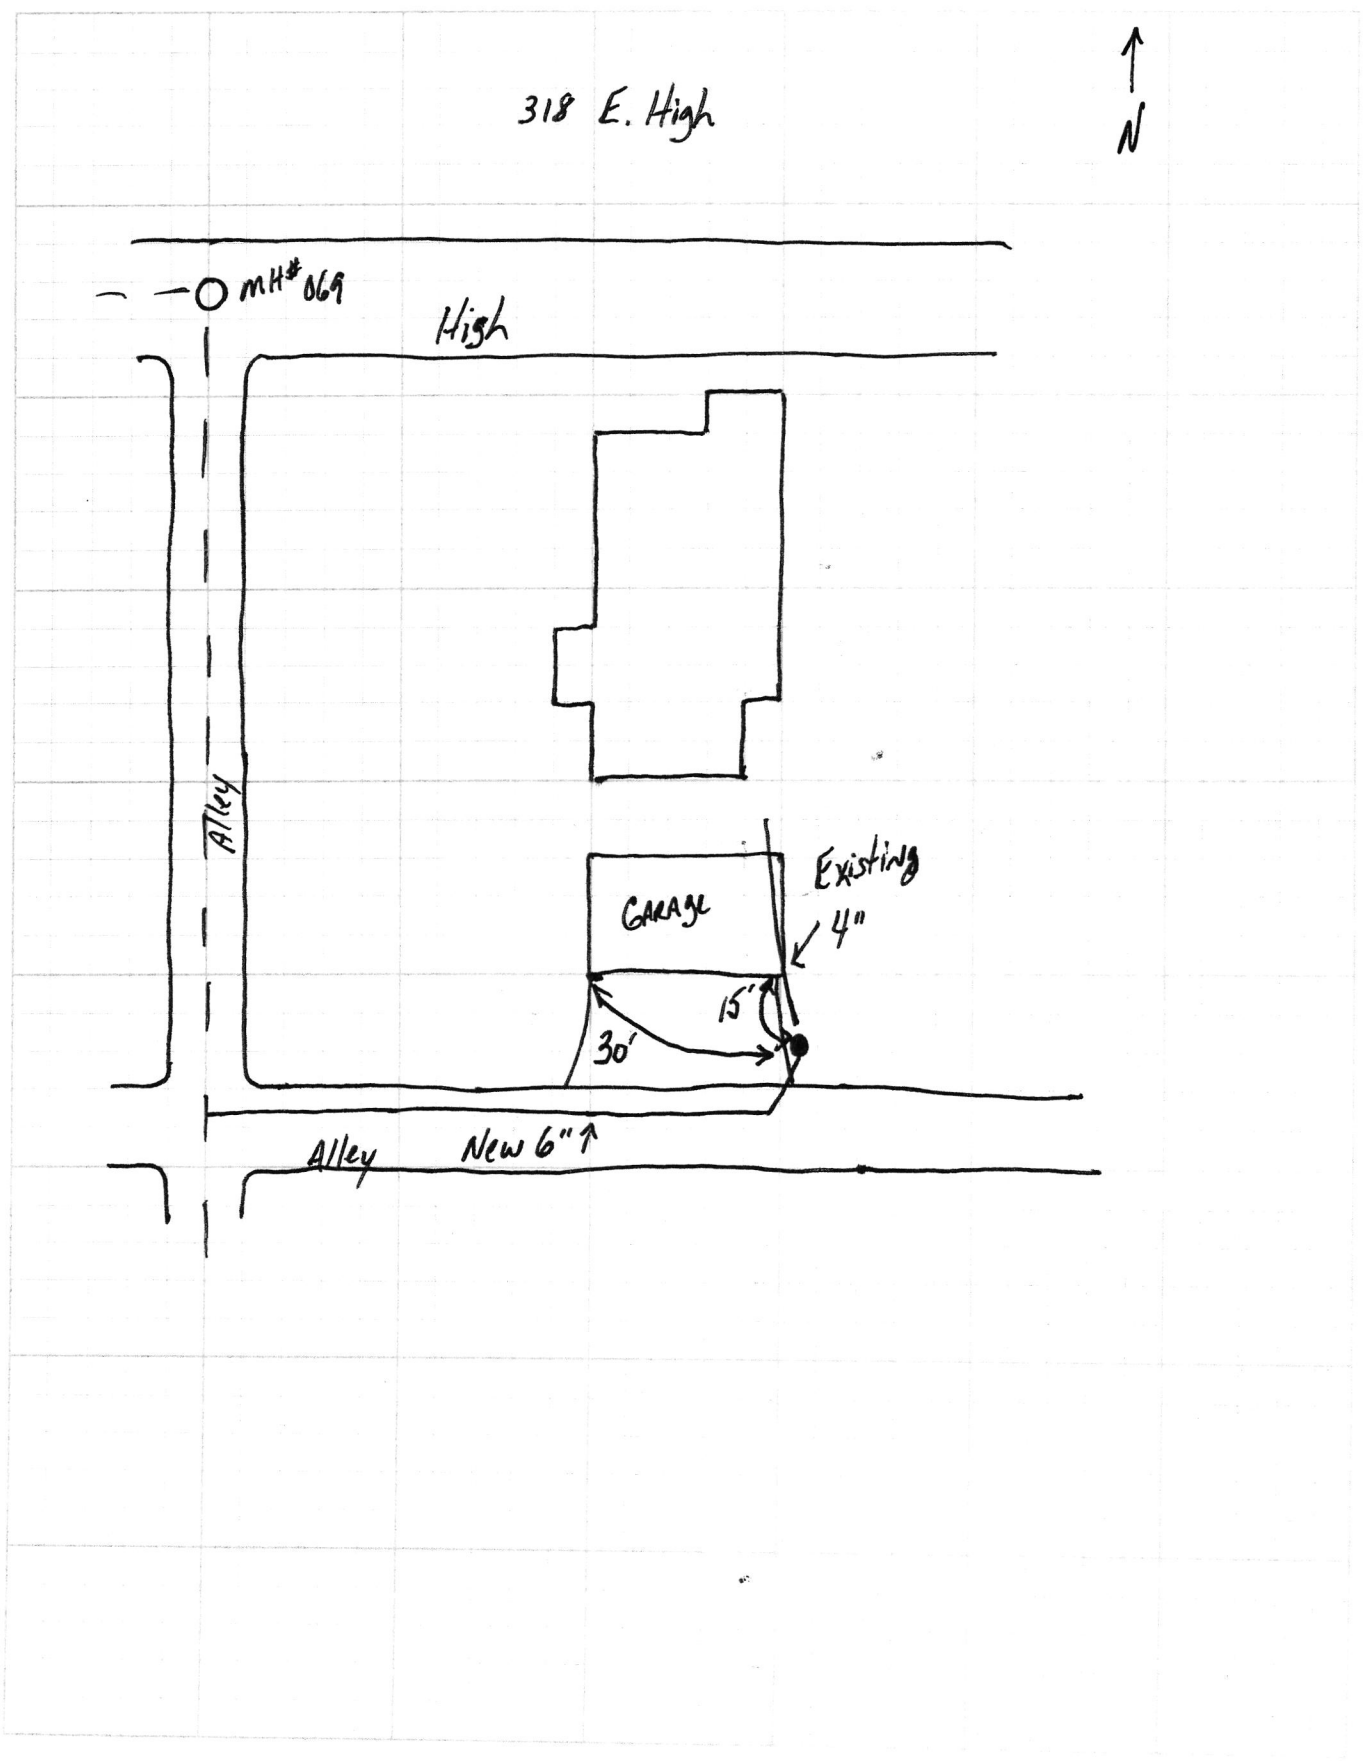

318 E High

SRF Phase II

7.11.18

