


Gidw.

PROJECT Phase II SHEET _____ OF _____
SUBJECT _____ DATE 4-12-18
JOB NO. 4447
BY Atlas

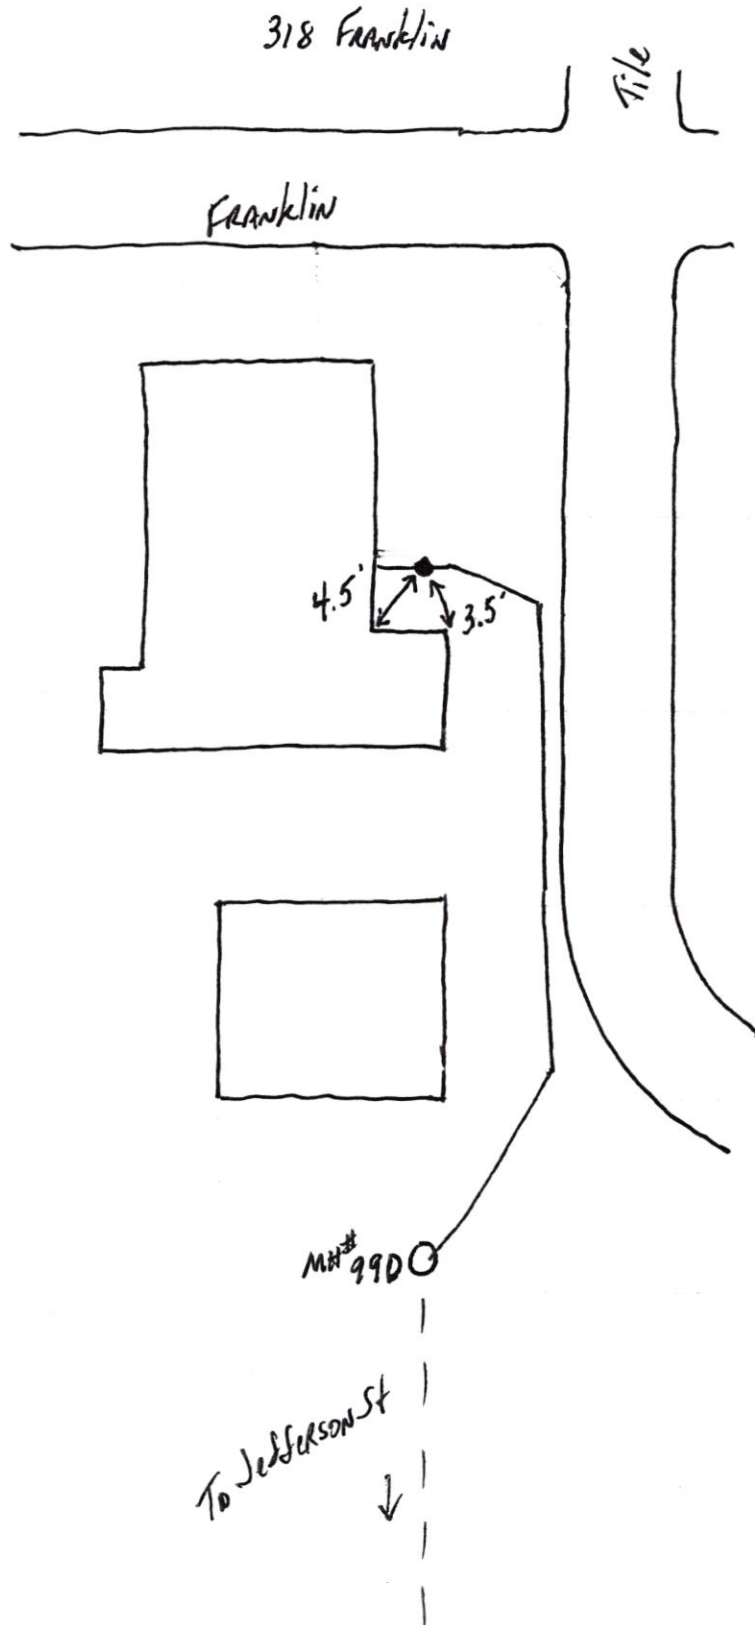

318 Franklin

SRF
Phase II

4.20.18



Repaired 12/21/2024

