

Gidw.



PROJECT Phase II SHEET _____ OF _____

SUBJECT _____ DATE 4-9-18

JOB NO. 4447

BY Atlas

~~321~~ S. Jefferson
319

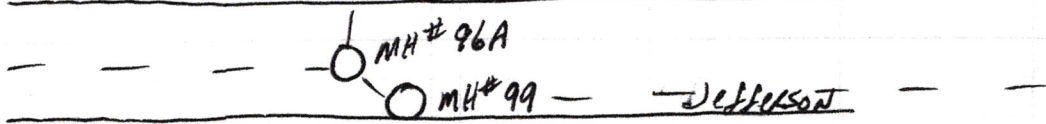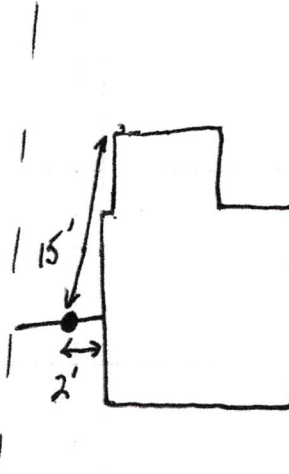

~~321~~ S Jefferson
319

SRP
Phase II

4.11.18

