


G.R.W.

PROJECT Phase II SHEET _____ OF _____

SUBJECT _____ DATE 9-13-18

JOB NO. 4447

BY A-HAS

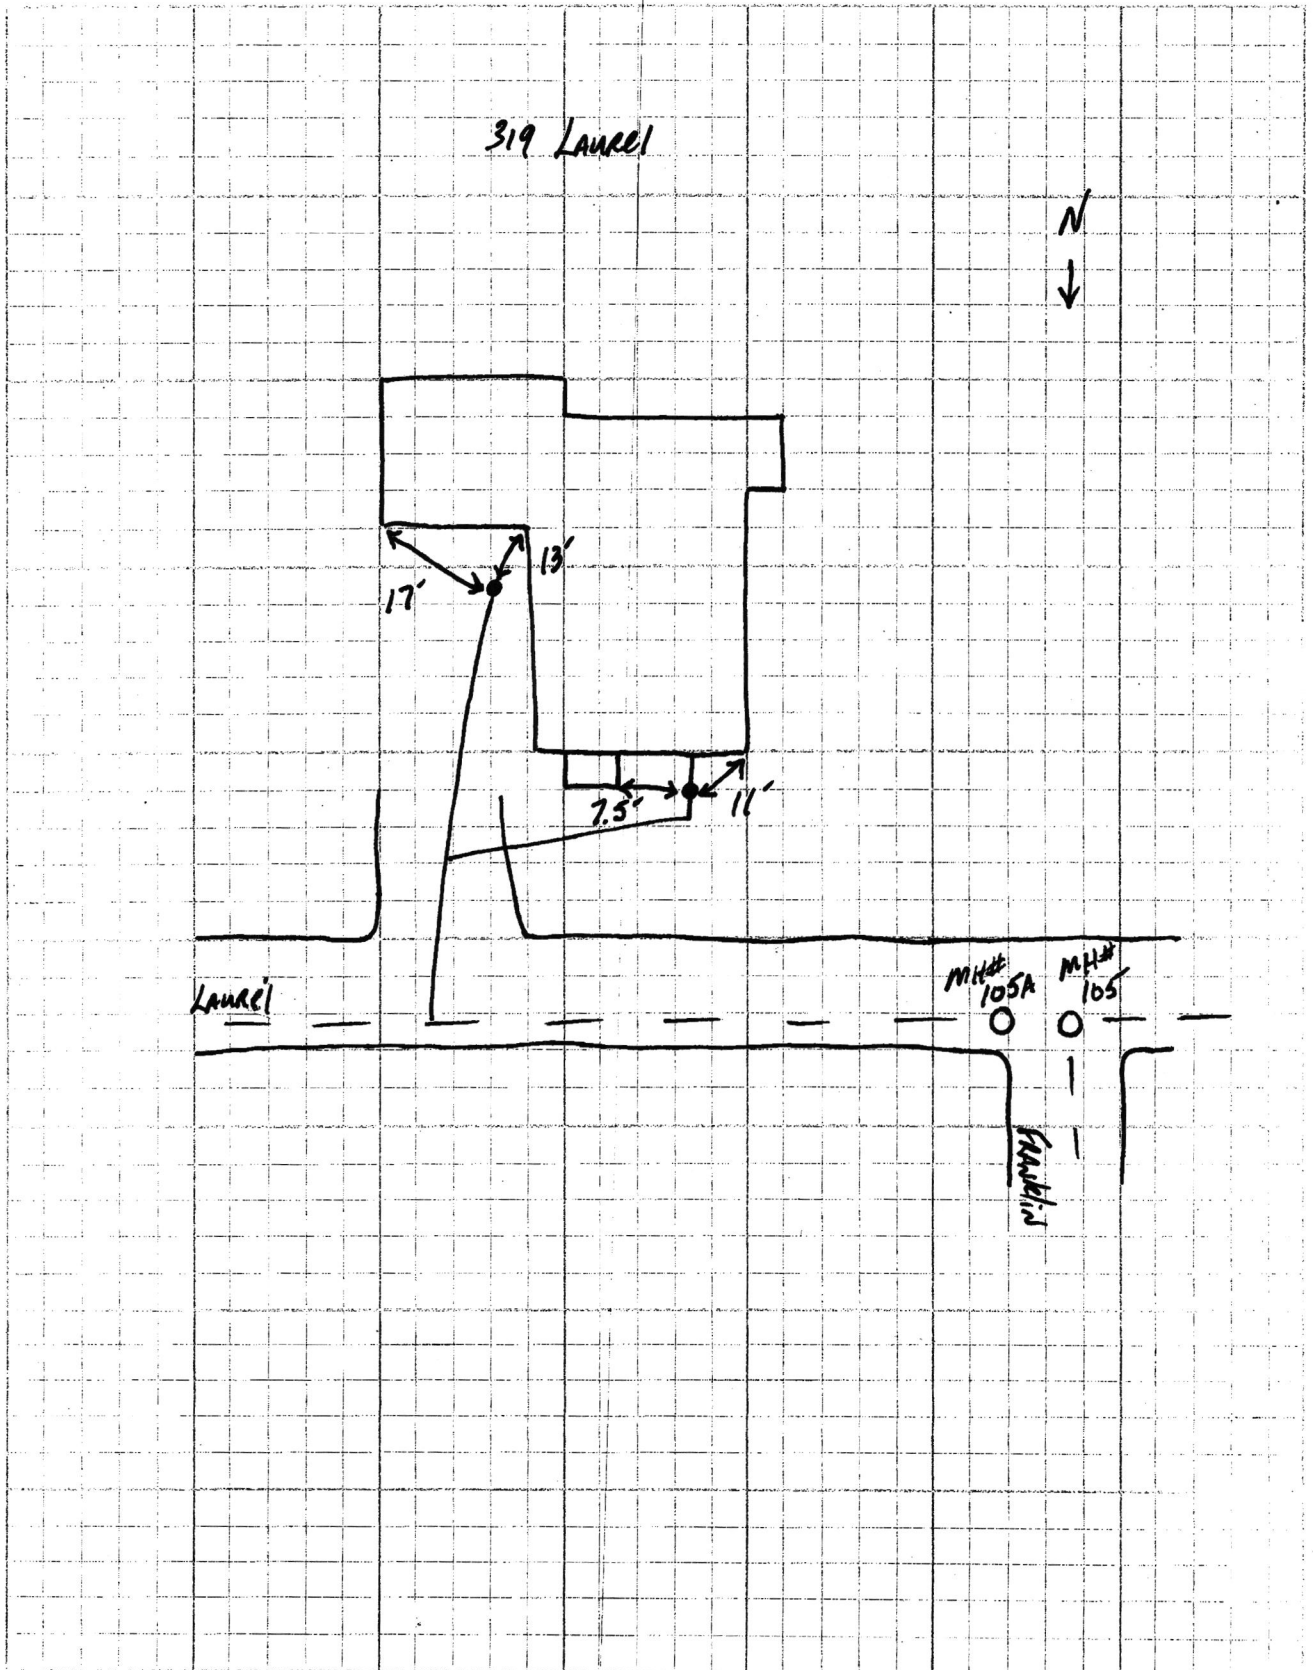

319 Laurel

SRF Phase II


9.13.18



Gidw.

PROJECT Phase II SHEET _____ OF _____
SUBJECT _____ DATE 2-28-18
JOB NO. 4447
BY Atlas

319 Laurel

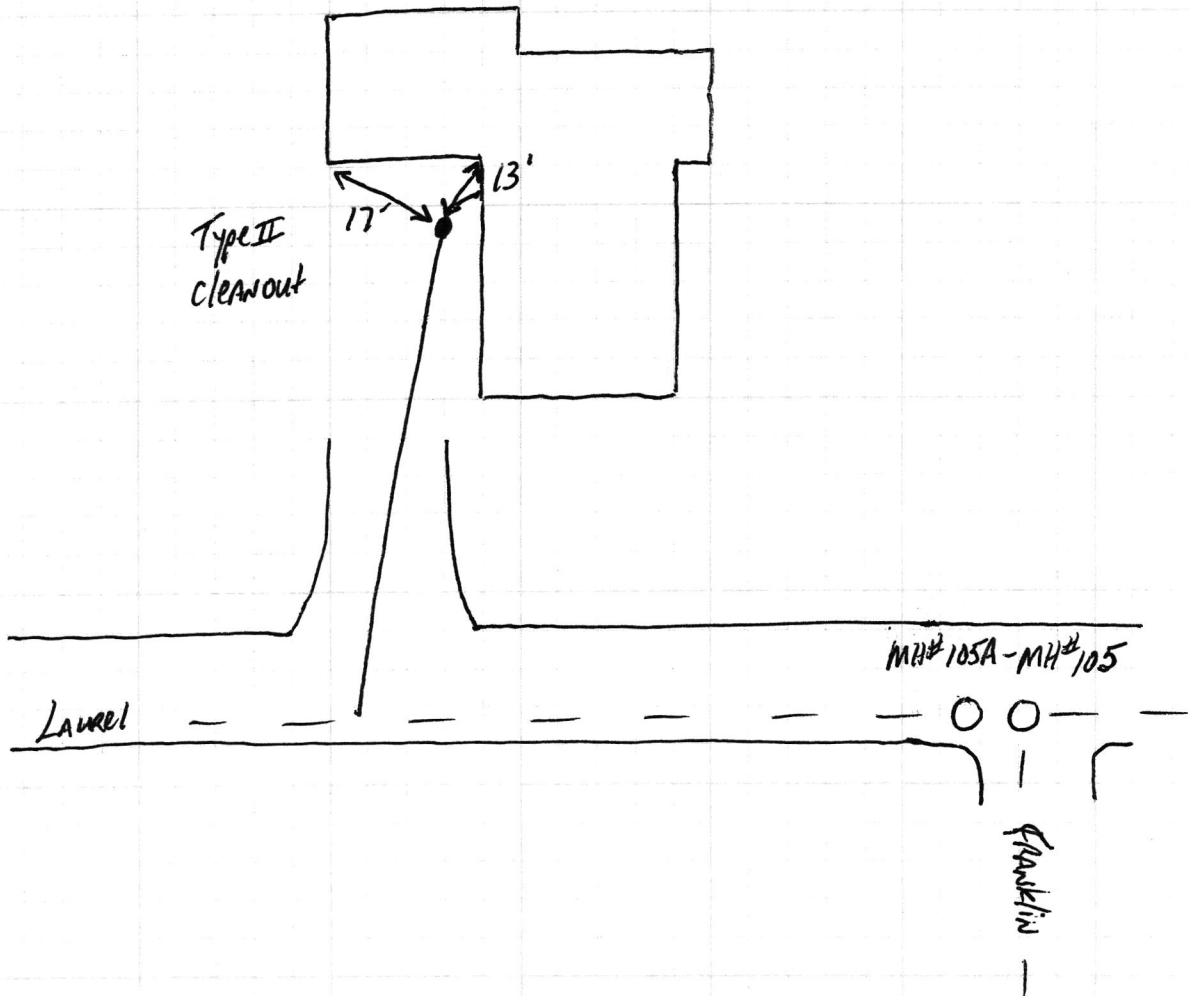

319 Laurel St
SRF Phase II

