


Gidw.

PROJECT Phase II SHEET \_\_\_\_\_ OF \_\_\_\_\_  
SUBJECT \_\_\_\_\_ DATE 7-23-18  
JOB NO. 4447  
BY Atlas

319 S. Broadway

N →

Broadway

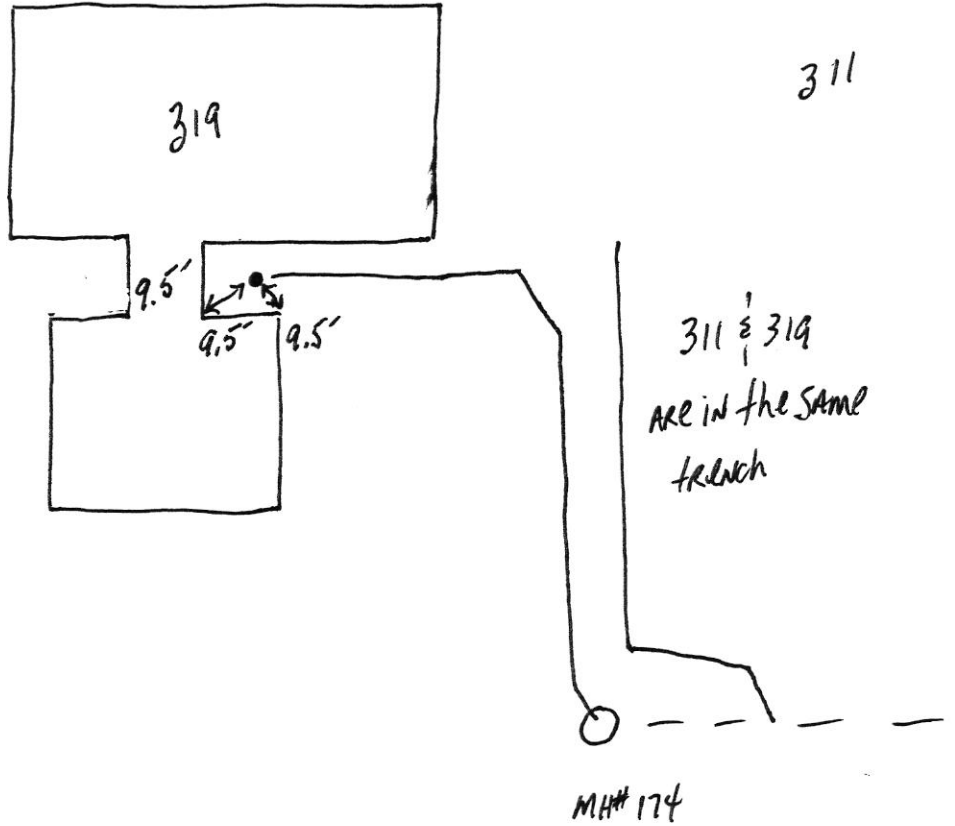

319 S Broadway

SRF Phase II

7.30.18

