


Gidw.

PROJECT Phase II SHEET _____ OF _____
SUBJECT _____ DATE 4-2-18
JOB NO. 4447
BY Atlas

319 High

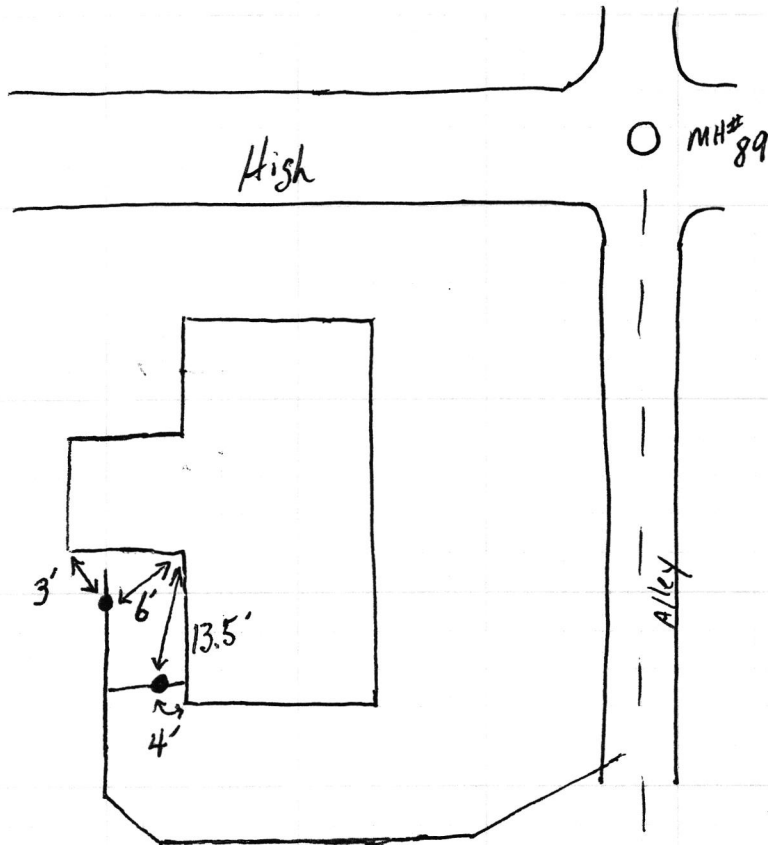

319 High

SRP Phase II

