



FALL CREEK REGIONAL WASTE DISTRICT

Box 44, Pendleton, Indiana 46064

1-0007200.00

Nº 000268

APPLICATION FOR SEWER PERMIT

Permit No. \_\_\_\_\_ Date 10-9-85

Permit Void 90 days from Date of Issuance

Owner Name BILL D. DUZAN [RENTER]

11250 FALL CREEK Rd.  
INDIANAPOLIS INDIANA 46256  
CHARLES BOLANDER

Property Address 321 ALFONTE ST

Lot # \_\_\_\_\_ P.O. Box \_\_\_\_\_

Town INGALLS, IN Zip Code \_\_\_\_\_

Phone 849-5287 Water Meter 5/8"

\$ 150.00 Tap on Fee Paid

\$ 25.00 Inspection fee paid

Application is hereby made for connection to the Fall Creek Regional Waste District Sewer System for the above listed property - Permit Type: Residential X, Commercial \_\_\_\_\_, Industrial \_\_\_\_\_, or Governmental/Institutional \_\_\_\_\_. User Information \_\_\_\_\_.

All workmanship and materials shall conform to the standards of the District Ordinance as described in Ordinance 84-2 and 84-3 as amended. Acceptance and approval must be made by the District inspector or his duly authorized representative before backfilling and final connection is made to the main sewer lines. Any violation of applicable regulations will cause all lines and appurtenances in violation to be removed and replaced at the owners expense.

The Fall Creek Regional Waste District is responsible for the inspection, approval of materials, and installation techniques only. All costs for materials and installation and any liabilities resulting from same is the sole responsibility of the property owner.

I have read and fully understand the above provisions and agree to comply by said provisions.

Bill D. Duzan

APPLICANT(S) SIGNATURE

INSPECTOR

B

Date inspected 10-29-81 Approved ✓ Rejected \_\_\_\_\_

Reason for rejection \_\_\_\_\_

Date reinspected \_\_\_\_\_ Approved \_\_\_\_\_ Rejected \_\_\_\_\_

Notes:

Size Pipe 6"

Type Pipe PVC

Basement Yes \_\_\_\_\_ No X


Sump Pump Yes \_\_\_\_\_ No X

Downspout to Ground Yes X No \_\_\_\_\_

Septic Tank Pumped & filled Yes \_\_\_\_\_ No X

Contractor Greg Holt

Special Conditions \_\_\_\_\_

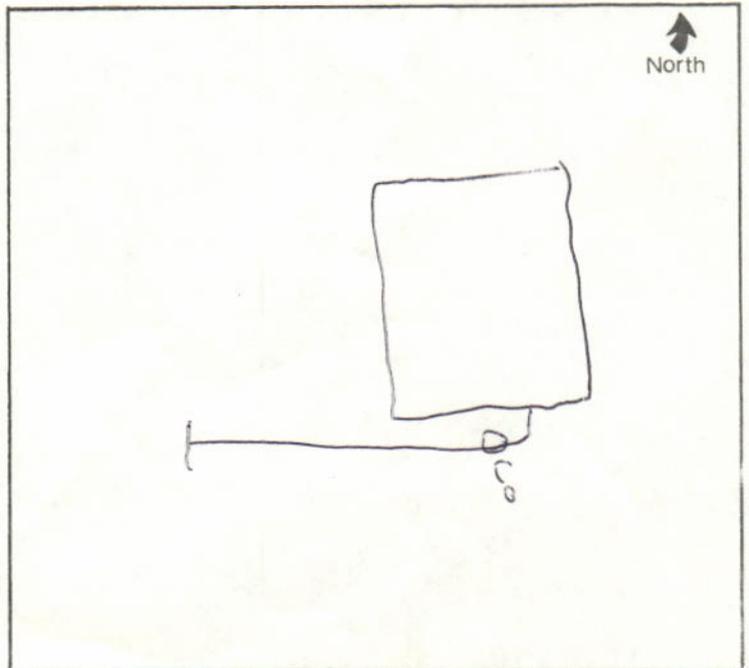

PH

# National Waterworks

## Indianapolis

(317) 271-1463

(800) 792-3461

Fax (317) 271-2026

## Bloomington

(812) 331-0356

(800) 859-5999

Fax (812) 331-0371

## Oaklandon

(317) 823-4474

Fax (317) 823-2363

## St. John

(219) 365-9995

(800) 771-9995

Fax (219) 365-9996

*"Local Service, Nationwide"*

1 1000  
② ③ ④ ⑤ ⑥ ⑦ ⑧ ⑨ ⑩

321

LOT ~~317~~ Alford

10

13  
319 Alford

Distributor of



Products