

Gidw.

PROJECT

Phase II

SHEET

OF

SUBJECT

DATE

4-30-18


JOB NO.

4447

BY

Atlas

321 W. State

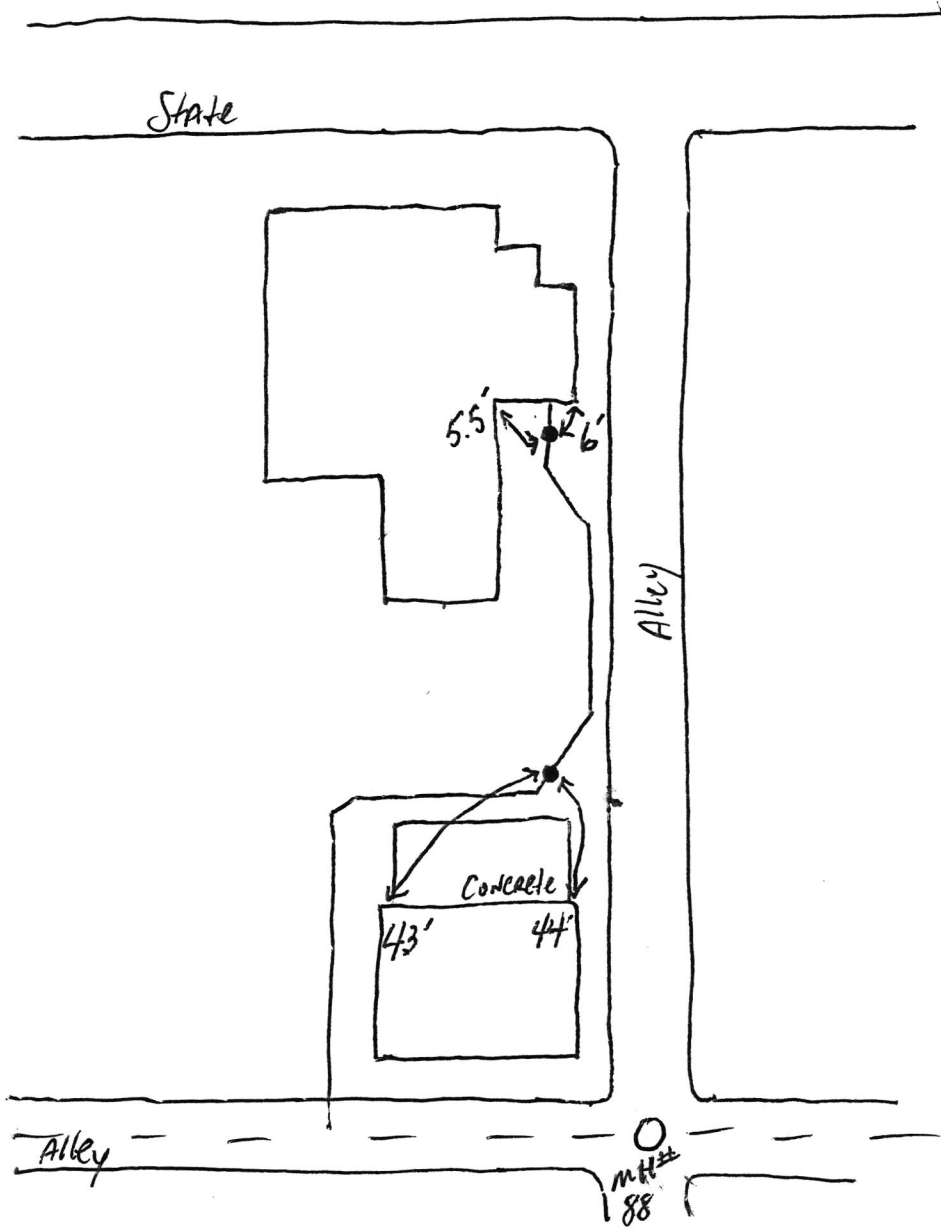

321 W State

SRF
Phase II

5.3.18



321 W State

SRP
Phase II

5.3.18

