




PROJECT Phase II SHEET _____ OF _____

SUBJECT _____ DATE 3-6-18

JOB NO. 4447

BY Atlas

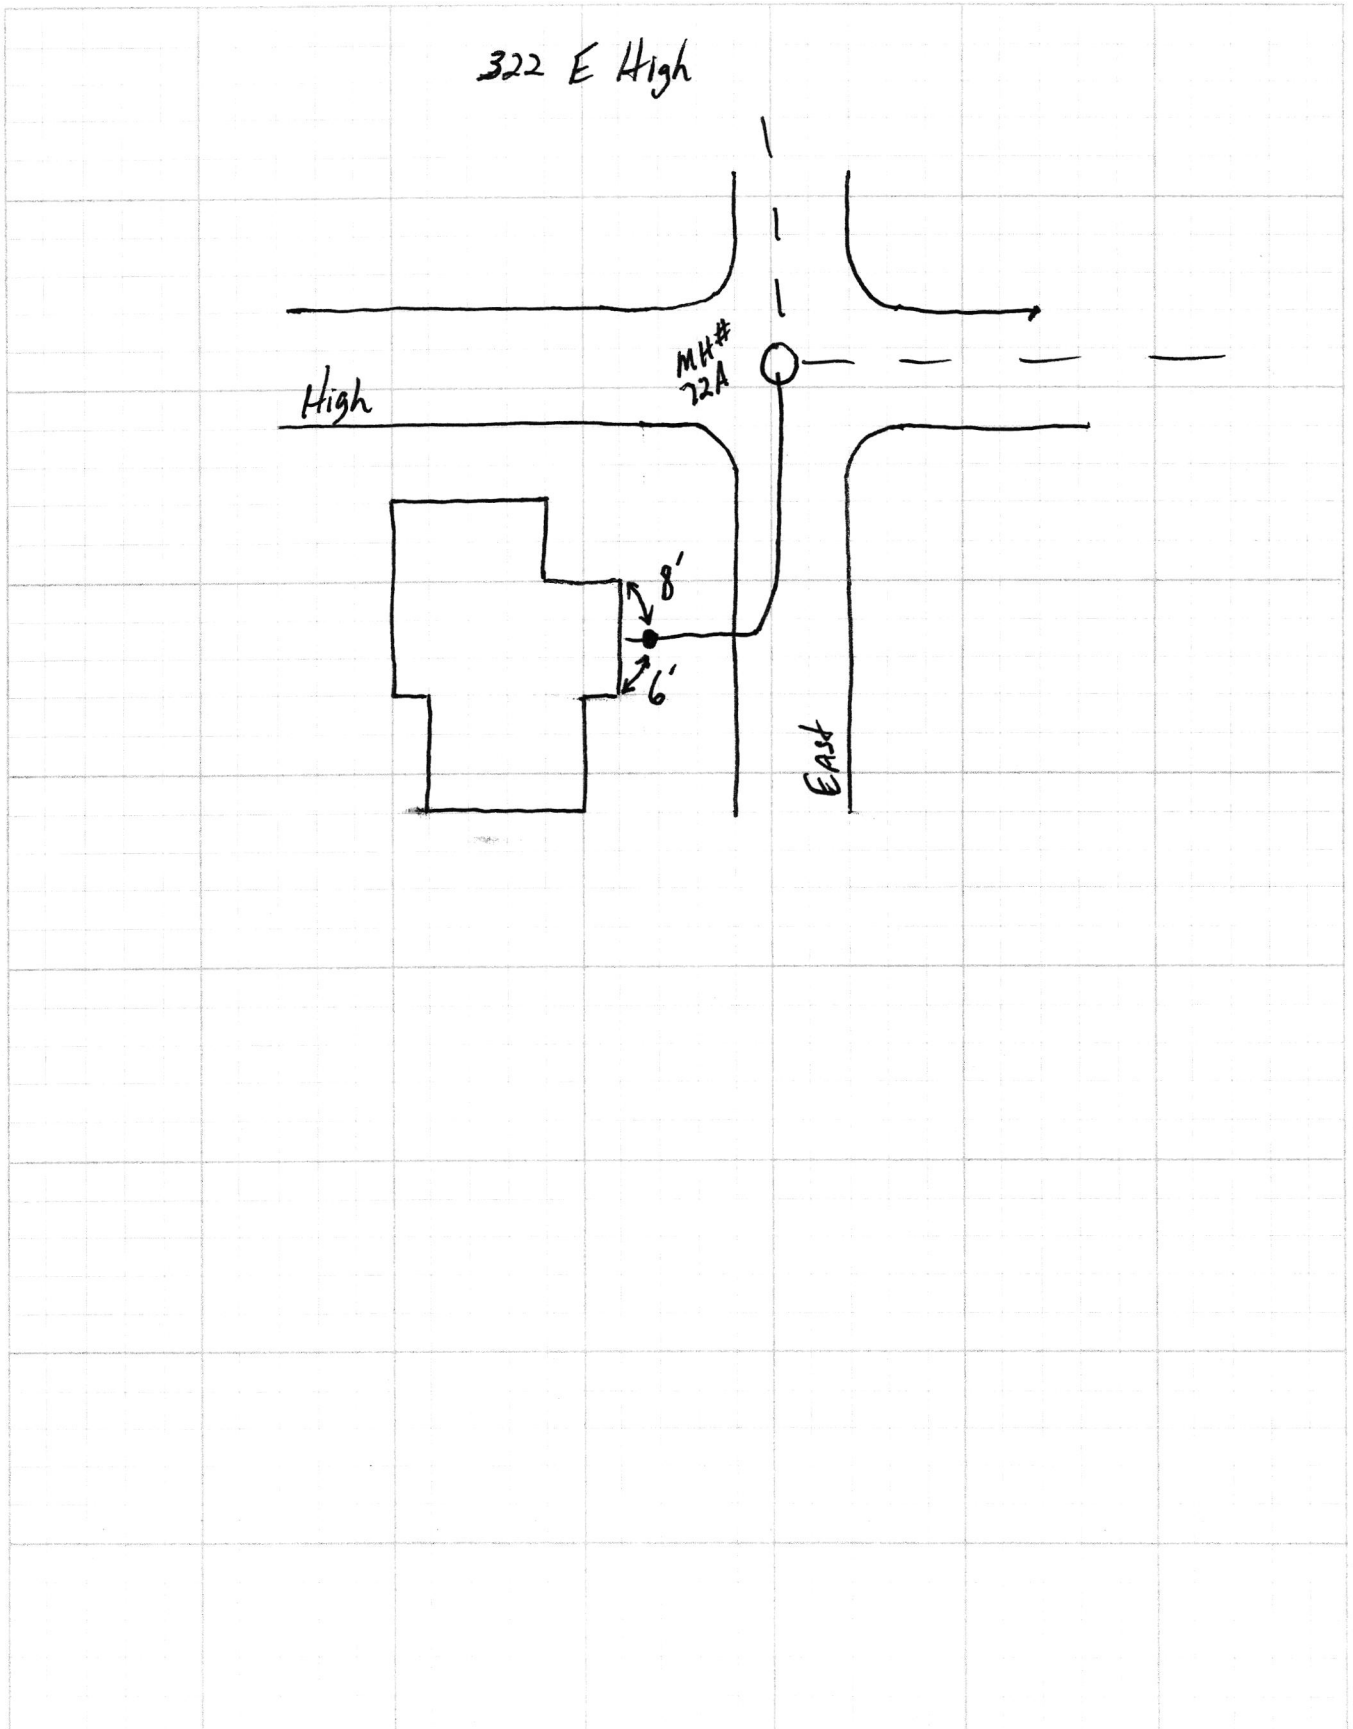

322 E High

SRP Phase II

