

Gidw.


PROJECT Phase II SHEET _____ OF _____

SUBJECT _____ DATE 2-1-18

JOB NO. 4447

BY Atlas

322 W. Taylor

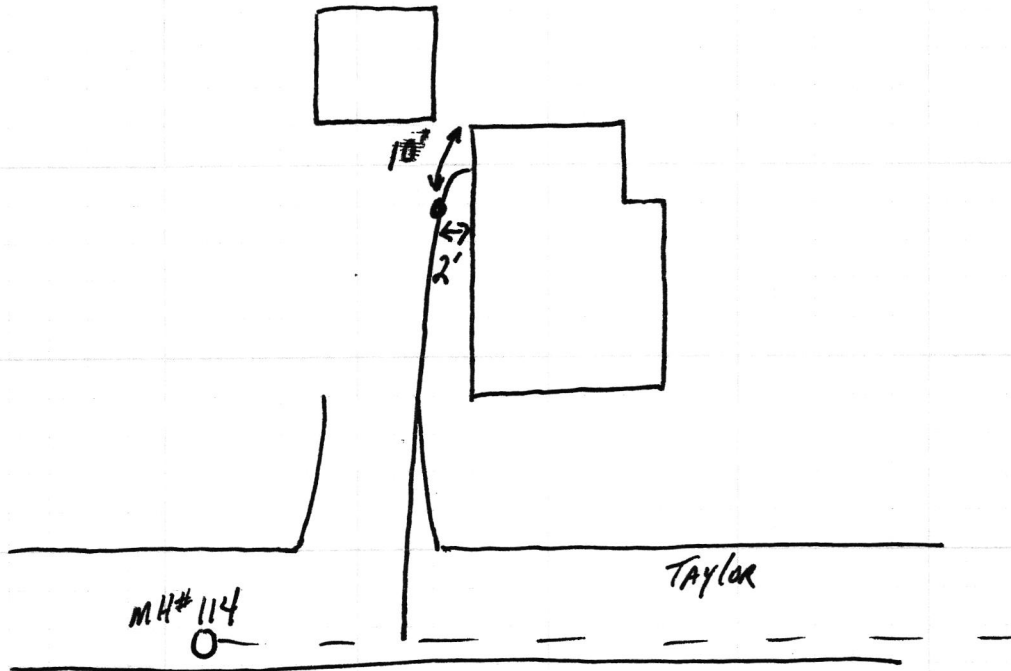

322 W Taylor

SRP Phase II

