

Gidw.

PROJECT Phase II SHEET _____ OF _____


SUBJECT _____ DATE 5-31-18

JOB NO. 4447

BY Atlas

323 S. Pearl

N →

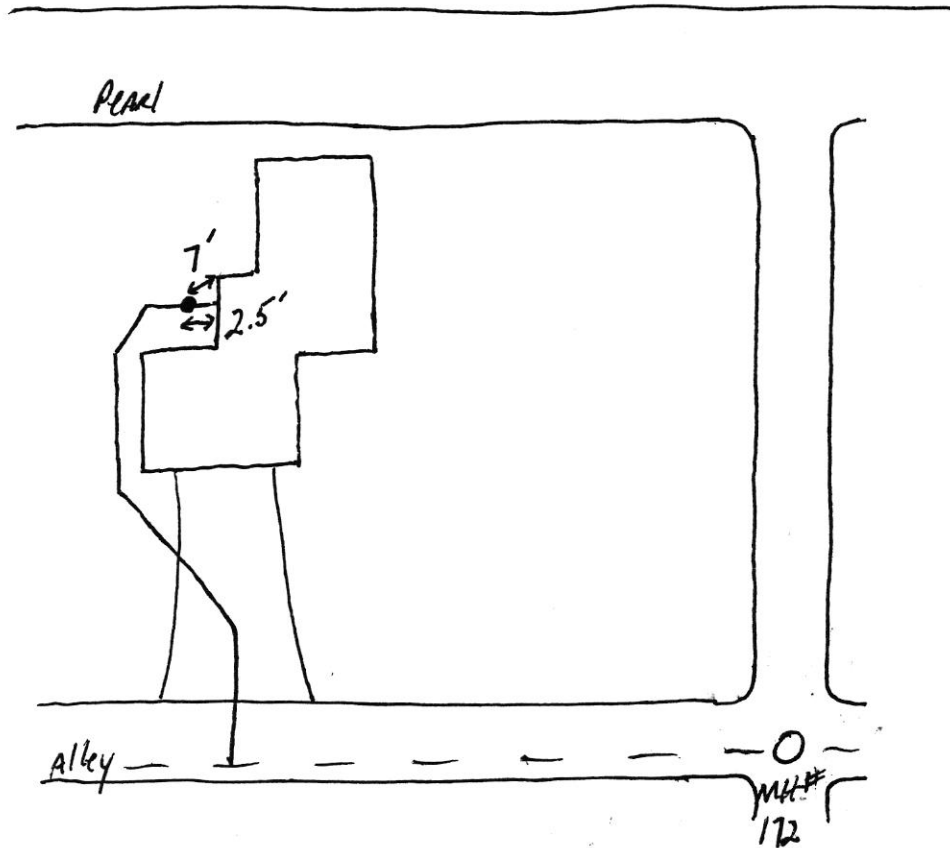



323 S Pearl

Soft Phase II

6-2-18