

GLW

PROJECT Phase II

SHEET _____ OF _____


SUBJECT _____

DATE 1-30-18

JOB NO. 4447

BY Atlas

323 W. Tile

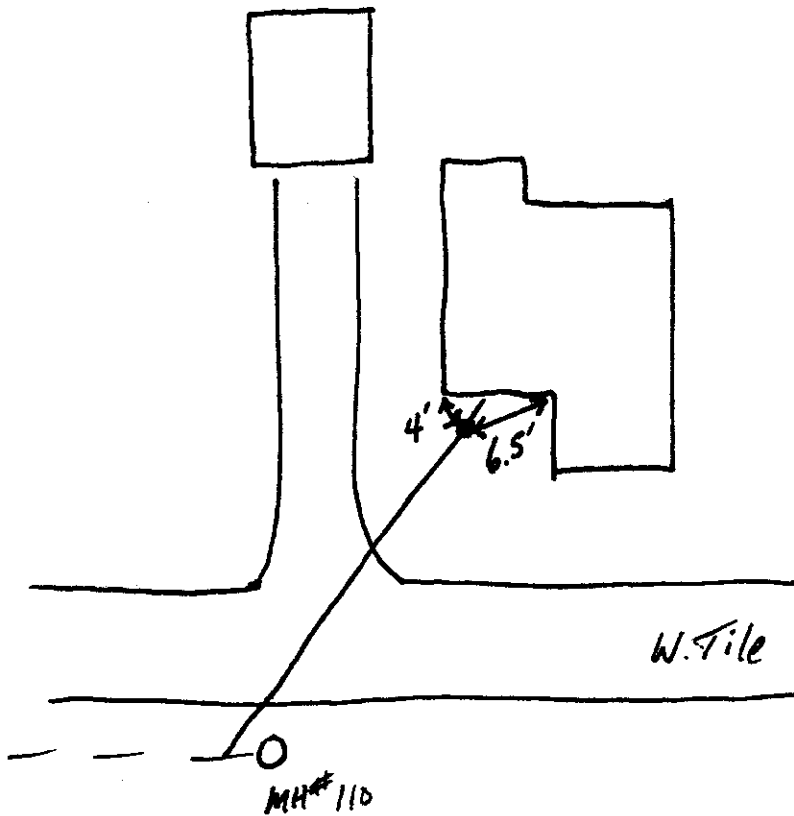

323 W Tile St

SRP Phase II

1/30/18

