



FALL CREEK REGIONAL WASTE DISTRICT

Box 44, Pendleton, Indiana 46064

12-86
WAIVER UNTIL
LIVABLE

1-0002630.01

APPLICATION FOR SEWER PERMIT

Nº 001501

Permit No. _____ Date 4-18-86
Permit Void 90 days from Date of Issuance
Owner Name Kevin Charlton
Property Address 325 N. Houston
Lot # _____ P.O. Box _____
Town Ingalls, IN Zip Code 46048
Phone 485-4591 Water Meter Ingress Notix
\$ 130.00 4-18- Tap on Fee Paid 75.00 pd 6-16-86
\$ 25.00 Inspection fee paid

Application is hereby made for connection to the Fall Creek Regional Waste District Sewer System for the above listed property - Permit Type: Residential ☒, Commercial _____, Industrial _____, or Governmental/Institutional _____. User Information _____.

All workmanship and materials shall conform to the standards of the District Ordinance as described in Ordinance 84-2 and 84-3 as amended. Acceptance and approval must be made by the District inspector or his duly authorized representative before backfilling and final connection is made to the main sewer lines. Any violation of applicable regulations will cause all lines and appurtenances in violation to be removed and replaced at the owners expense.

The Fall Creek Regional Waste District is responsible for the inspection, approval of materials, and installation techniques only. All costs for materials and installation and any liabilities resulting from same is the sole responsibility of the property owner.

I have read and fully understand the above provisions and agree to comply by said provisions.

Dimee N. Charlton
APPLICANT(S) SIGNATURE


INSPECTOR BEN

Date inspected 2-23-87 Approved ☒ Rejected _____
Reason for rejection _____

Date reinspected _____ Approved _____ Rejected _____

Notes:

Size Pipe 6 "
Type Pipe PVC
Basement Yes _____ No ☒
Sump Pump Yes _____ No ☒
Downspout to Ground Yes ☒ No _____
Septic Tank Pumped & filled Yes _____ No _____
Contractor W. CONNER
Special Conditions _____

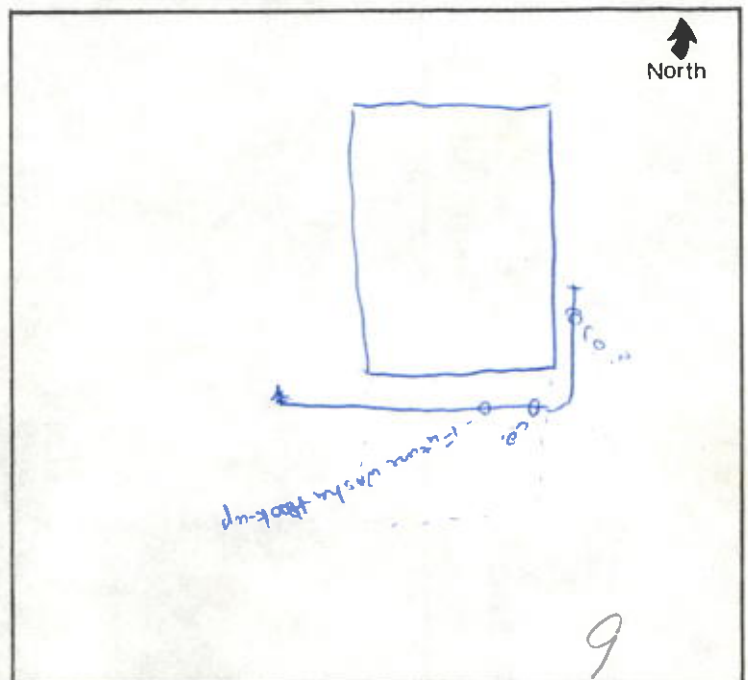



FALL CREEK REGIONAL WASTE DISTRICT

Box 11, Padgett, Idaho 83424

NO 001201

Project No. 4-18-86
Project Name: Kevin Charlton
Property Address: 392 N. Houston
City: Tropic
County: Blaine
State: Idaho
Zip: 83424
Phone: 485-4271
Fax: 485-4271
E-mail: kcharlton@tropicidaho.com

Project Description: The project is a residential development consisting of 10 lots, each 1/4 acre in size, located in the Tropic area. The lots are currently vacant and are being offered for sale. The project is being developed by Kevin Charlton.

All water supply for the project will be obtained from the Tropic area. The project is being developed in accordance with the Tropic area water supply plan. The project is being developed in accordance with the Tropic area water supply plan.

The Fall Creek Regional Waste District is responsible for the collection, transport, and disposal of solid waste. The district is responsible for the collection, transport, and disposal of solid waste.

I have read and understand the above information and agree to the terms and conditions of the project. I have read and understand the above information and agree to the terms and conditions of the project.

Signature: Kevin Charlton
Date: 4-18-86

Project No. 4-18-86
Project Name: Kevin Charlton
Property Address: 392 N. Houston
City: Tropic
County: Blaine
State: Idaho
Zip: 83424
Phone: 485-4271
Fax: 485-4271
E-mail: kcharlton@tropicidaho.com

