

Gidw.

PROJECT Phase II SHEET _____ OF _____

SUBJECT _____ DATE 5-30-18


JOB NO. 4447

BY Atlas

325 S. Pearl

N →

Pearl

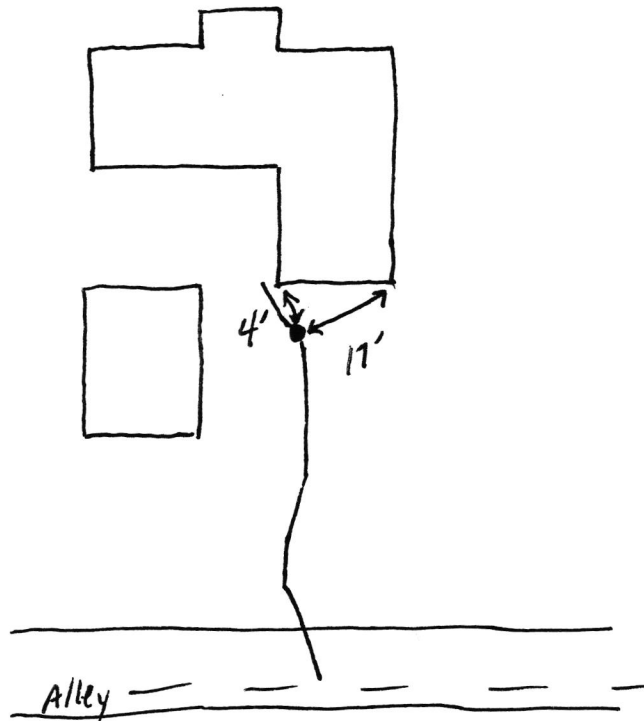

S&S > Year 1

S&S Phase II

6.2.18

