

BY Atlas


Gidw.

PROJECT Phase II SHEET _____ OF _____

SUBJECT _____ DATE 4-2-18

JOB NO. 4447

BY Atlas

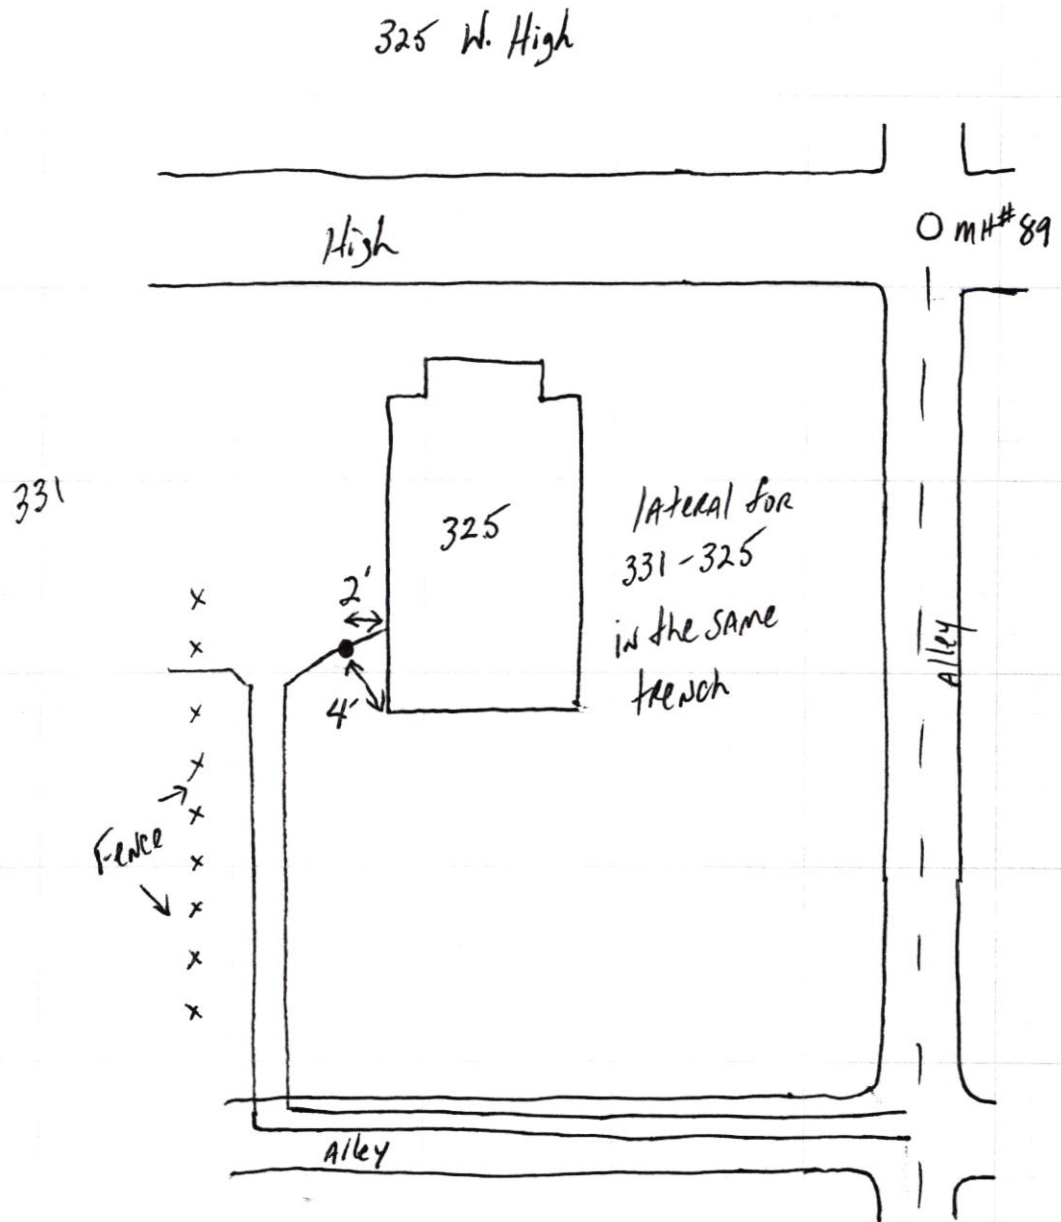

331 High
325 High

UP 11.000 ft

4.9.18



325 High

SRP Phase II

