


Gidw.

PROJECT Phase II SHEET _____ OF _____

SUBJECT _____ DATE _____

JOB NO. 4447

BY Atlas

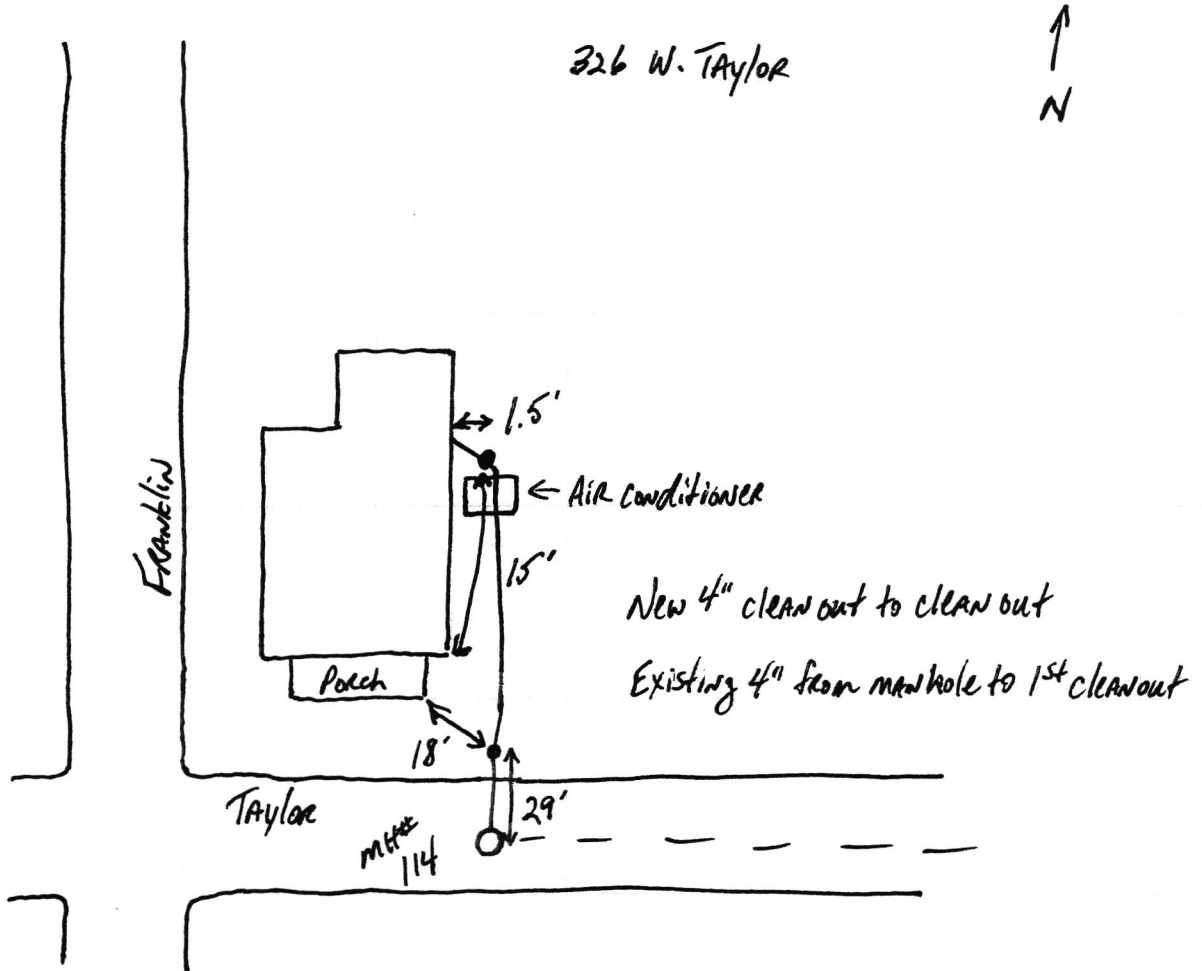

3ale W Taylor

SNF Phase II

6.11.18



326 W Taylor

SRF Phase II

6.11.18

