


Gidw.

PROJECT Phase II SHEET _____ OF _____
SUBJECT _____ DATE 5-17-18
JOB NO 4447
BY Atlas

327 S. Pendleton

N →

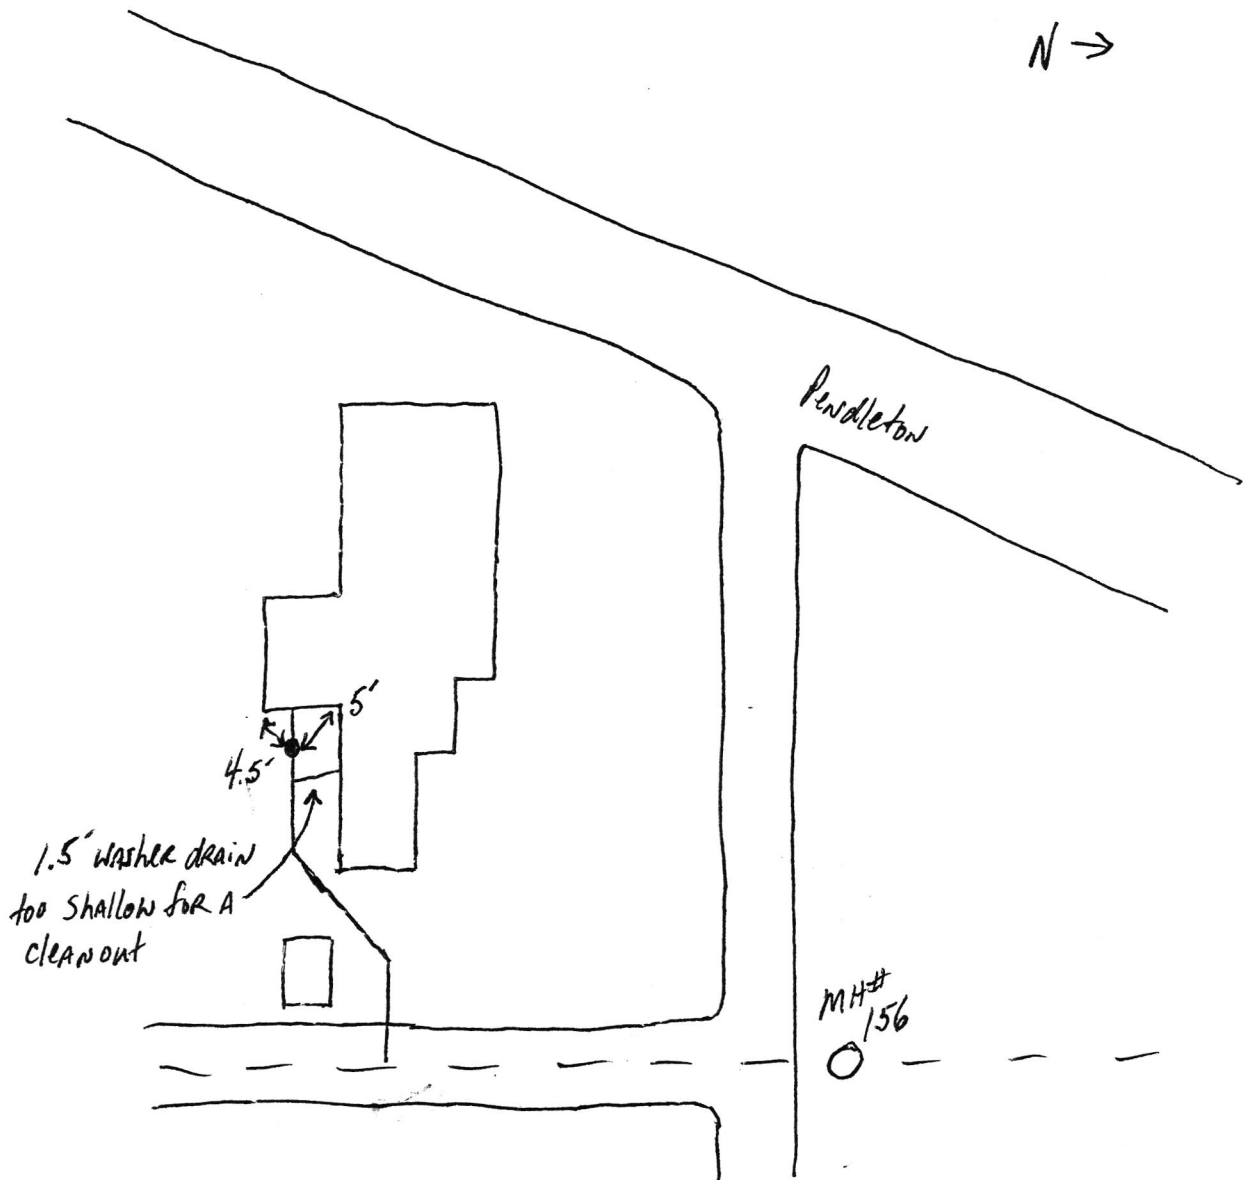

327 S Rendleton

SFP Phase II

5.22.18

