

Side


PROJECT Phase II SHEET _____ OF _____

SUBJECT _____ DATE 5-1-18

JOB NO. 4447

BY Atlas

331 - 327 State & 115 Franklin

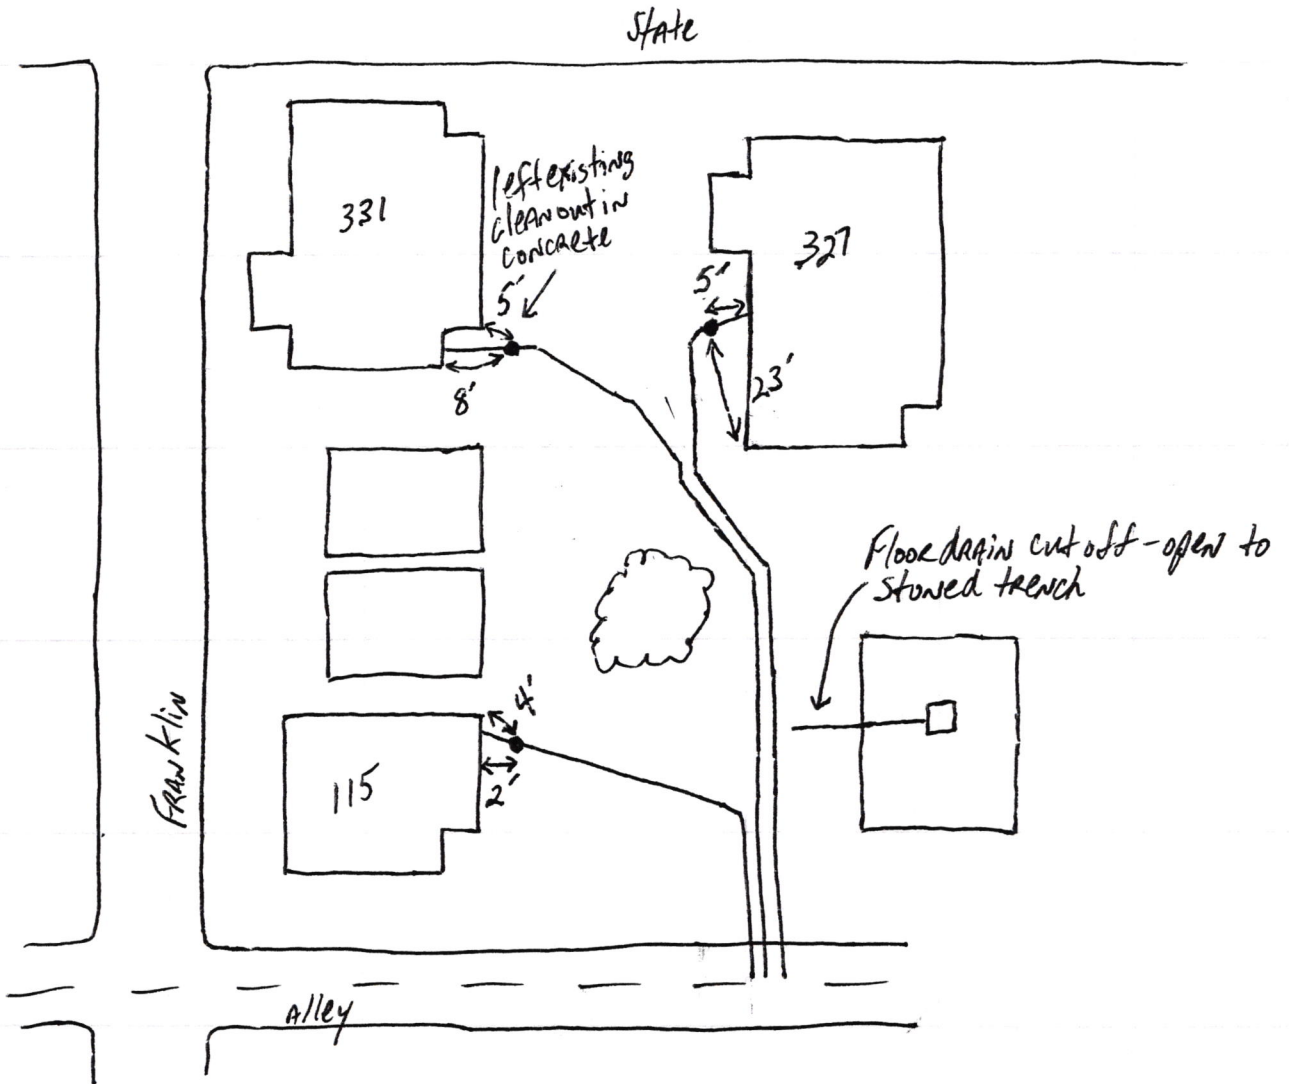

327 W State

SRP
Phase II

5.3.18

