


Gidw.

PROJECT Phase II SHEET _____ OF _____
SUBJECT _____ DATE 5-30-18
JOB NO. 4447
BY Atlas

328 S. East

← N

East

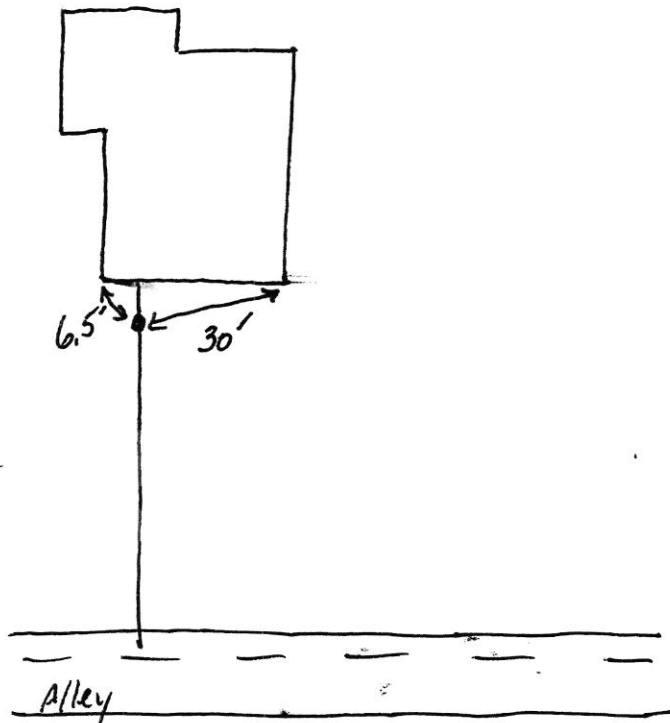

328 S East SRF Phase II

6-2-18



Sid > East

SRF Phase II

6.2.18

