
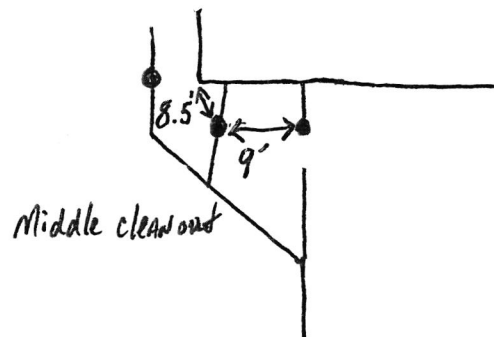


GLW

PROJECT Phase II SHEET _____ OF _____
SUBJECT _____ DATE 5-2-18
JOB NO. 44617
BY Atlas

328 S. Moore

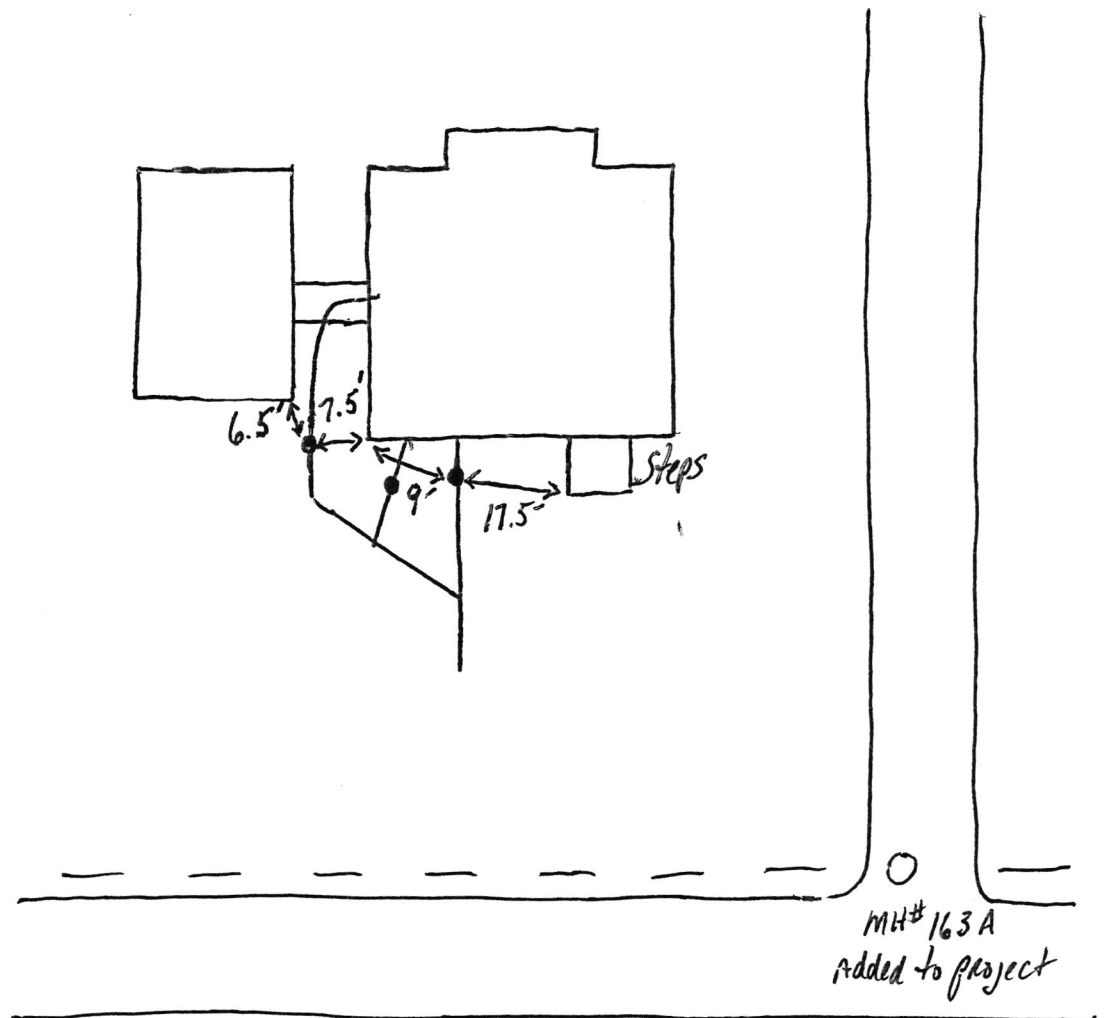

328 moore

SRF
Phase II

5.3.18



328 Moore

SRP
Phase II

5.3.18

