

Gidw.

PROJECT Phase II SHEET _____ OF _____


SUBJECT _____ DATE 7-26-18

JOB NO. 4447

BY A-Mas

328 S. Pearl

← N

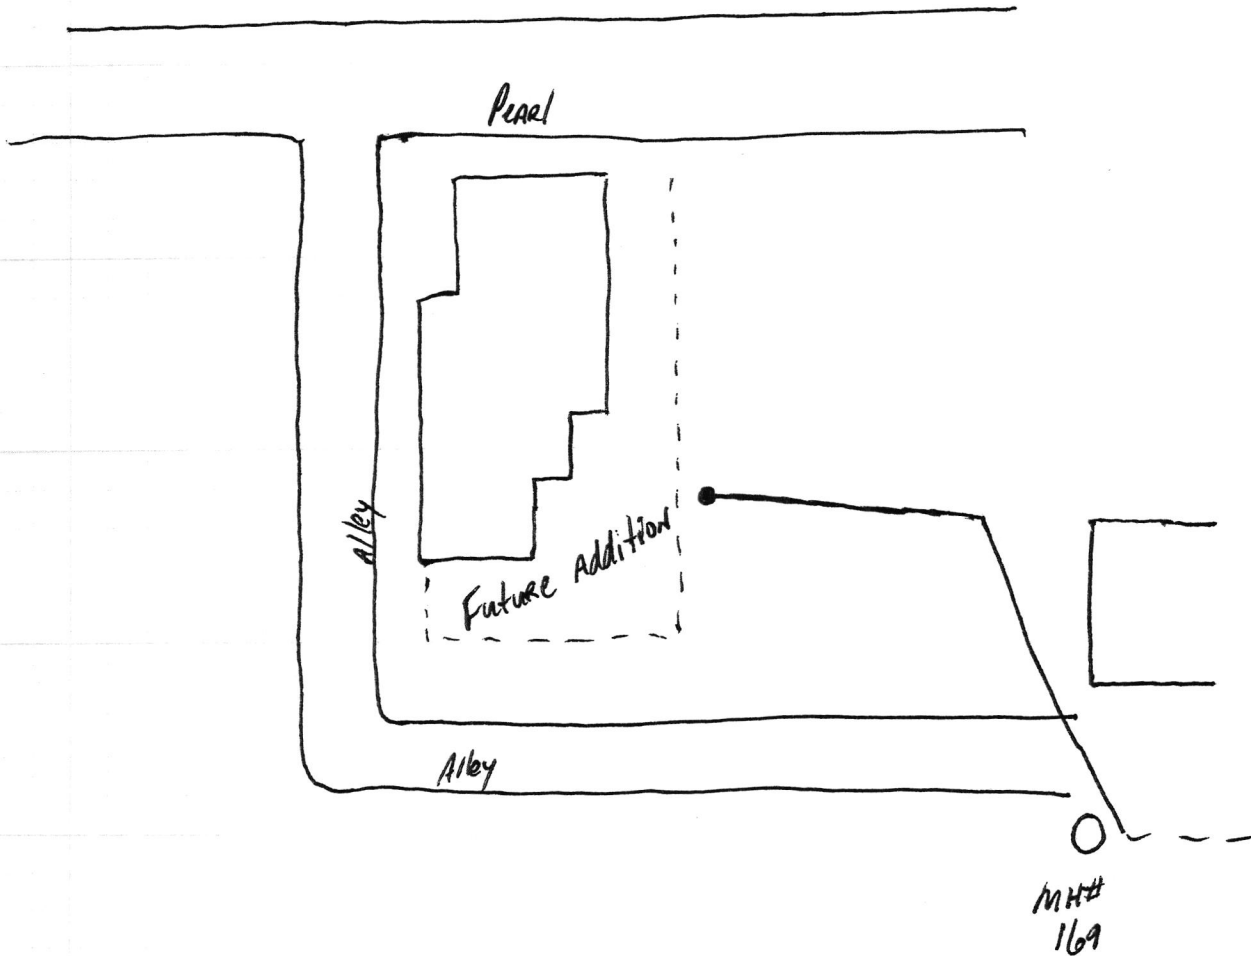

328 S Pearl

SRF Phase II

7.30.18

