



FALL CREEK REGIONAL WASTE DISTRICT

Box 44, Pendleton, Indiana 46064

1-0002915.00

Nº 000221

APPLICATION FOR SEWER PERMIT

Permit No. \_\_\_\_\_ Date 10-1-85  
Permit Void 90 days from Date of Issuance  
Owner Name Max B. Gill 32 Myresia Ave  
Property Address Lot 22 Inman Est.  
Lot # \_\_\_\_\_ P.O. Box 415  
Town Ingalls, IN Zip Code 46048  
Phone 778-4336 Water Meter Ing."  
\$ Free Tap on Fee Paid  
\$ 25.00 Inspection fee paid

Application is hereby made for connection to the Fall Creek Regional Waste District Sewer System for the above listed property - Permit Type: Residential ☒, Commercial \_\_\_\_\_, Industrial \_\_\_\_\_, or Governmental/Institutional \_\_\_\_\_. User Information \_\_\_\_\_.

All workmanship and materials shall conform to the standards of the District Ordinance as described in Ordinance 84-2 and 84-3 as amended. Acceptance and approval must be made by the District inspector or his duly authorized representative before backfilling and final connection is made to the main sewer lines. Any violation of applicable regulations will cause all lines and appurtenances in violation to be removed and replaced at the owners expense.

The Fall Creek Regional Waste District is responsible for the inspection, approval of materials, and installation techniques only. All costs for materials and installation and any liabilities resulting from same is the sole responsibility of the property owner.

I have read and fully understand the above provisions and agree to comply by said provisions.


Max B. Gill  
APPLICANT(S) SIGNATURE

\*\*\*\*\*

INSPECTOR Bu  
Date inspected 10-3-85 Approved ☒ Rejected \_\_\_\_\_  
Reason for rejection \_\_\_\_\_

Date reinspected \_\_\_\_\_ Approved \_\_\_\_\_ Rejected \_\_\_\_\_

Notes:  
Size Pipe 6""  
Type Pipe PVC  
Basement Yes \_\_\_\_\_ No ☒  
Sump Pump Yes \_\_\_\_\_ No ☒  
Downspout to Ground Yes ☒ No \_\_\_\_\_  
Septic Tank Pumped & filled Yes ☒ No \_\_\_\_\_  
Contractor FLATRODSON  
Special Conditions \_\_\_\_\_

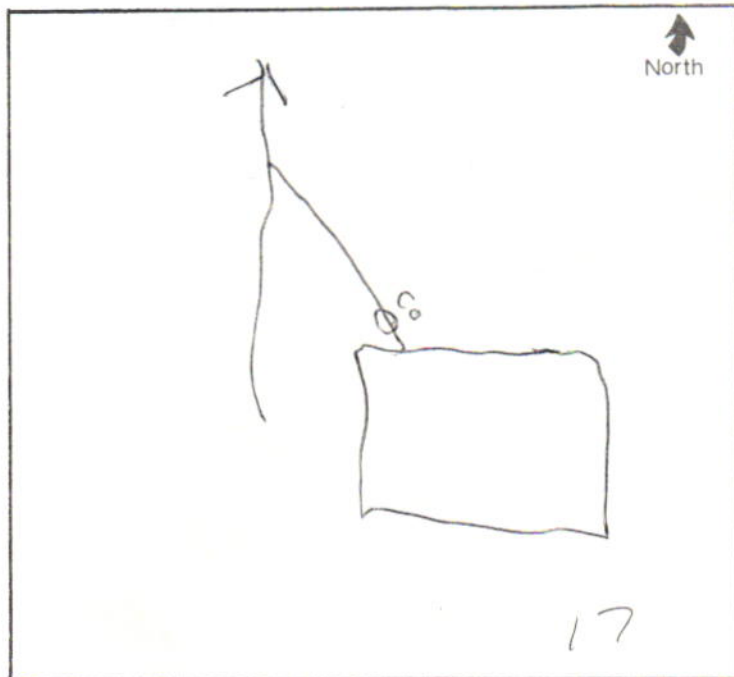

*Johnson & Whisler*

*Attorneys at Law*

*Walter R. Johnson  
David H. Houser*

*One South Main Street*

*Fortsville, Indiana 46040*

*(317) 485-6411*

October 31, 1984

Michael R. Withers  
Attorney at Law  
131 West Ninth Street  
Anderson, Indiana 46016

Re: Max B. and Teresa L. Gill


Dear Mike:

This letter will confirm our conversation wherein as attorney for the Fall Creek Waste District, it is agreed that your clients Max B. and Teresa L. Gill will have a free hook-on to the sanitation system when it is available.

This agreement for a free hook-on is granted as consideration for your client not taking action to prevent the sewer line going across his property.

Your client will still be responsible to pay the inspection fee which is \$25.00 which will be the charge made for the inspection of his lateral that is brought from his house to the sewer line. This lateral is at your client's own expense.

Very truly yours,

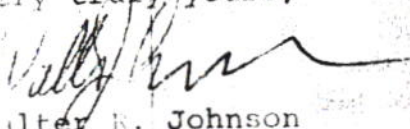  
Walter R. Johnson

WRJ/ m