

connected

North

~~Seam located lines~~


~~3.4.2001~~

~~Contractor did not~~

~~contact for inspection~~

Drawing +  
2 pictures attached



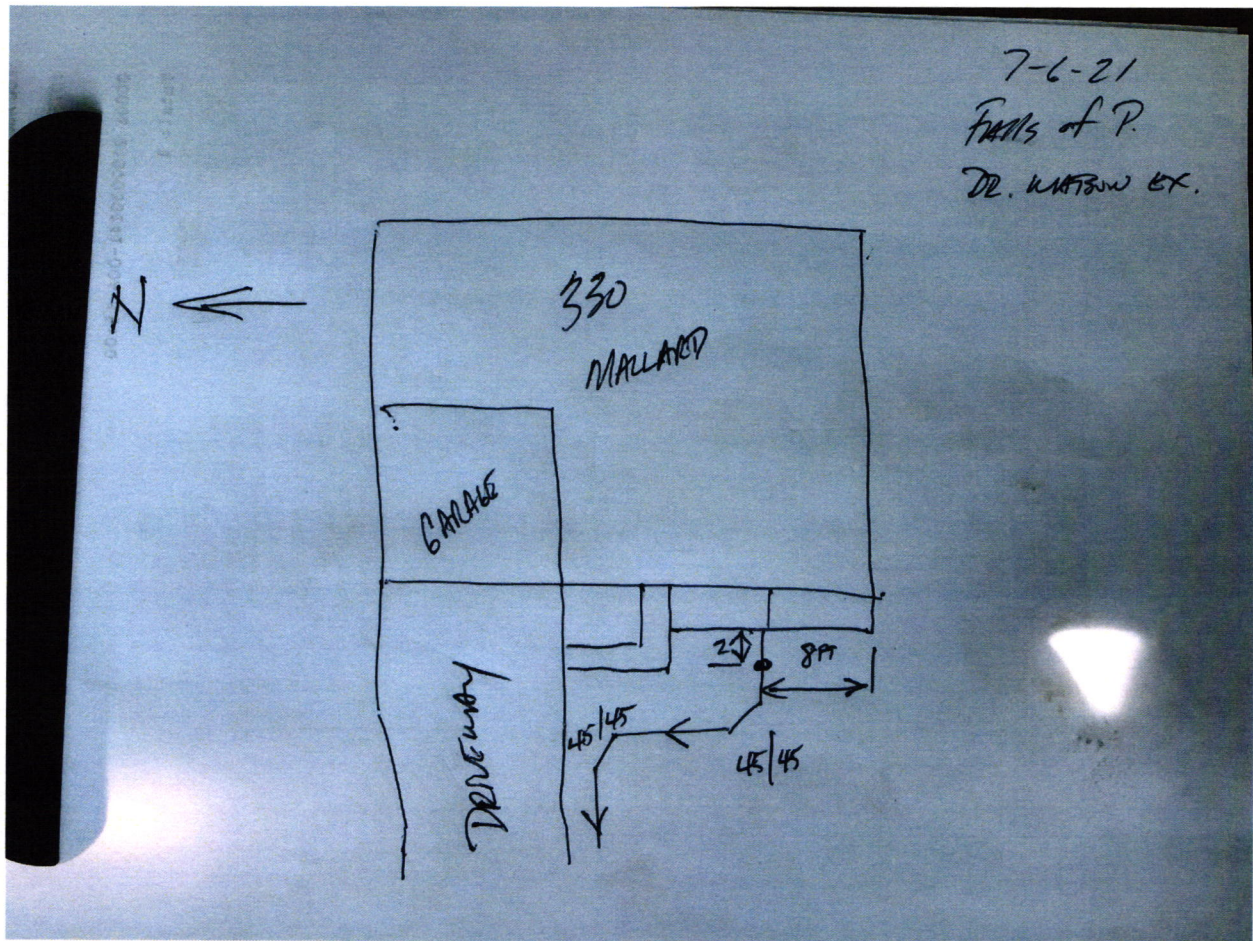











MODEL =  
HARRISON CRAFTSMAN  
F.F.ELEV. = 872.97  
BSMT. = 863.18  
(LH)

GAR.  
871.80

PORCH

CONC.  
DRIVE

D. & U. E.  
T.C. =

T.C. = 869.93 ±





FALL CREEK REGIONAL WASTE DISTRI  
9378 S 650 W  
PO BOX 59  
PENDLETON, IN 46064  
765-778-7544

FALL CREEK REGIONAL WASTE DIST  
0005560008022120839000

Date: 11/24/2020 10:19:55 AM

CREDIT CARD SALE  
R-E-P-R-I-N-T

VISA  
CARD NUMBER: \*\*\*\*\*5166 K  
TRAN AMOUNT: \$1,520.00  
APPROVAL CD: 099915  
ECI:  
RECORD #: 000  
CLERK ID: Rachel  
SALES TAX: \$0.00  
INVOICE #: FALLS OF PENDLETON

X \_\_\_\_\_  
ARBOR HOMES

I AGREE TO PAY THE ABOVE TOTAL AMOUNT  
ACCORDING TO THE CARD ISSUER AGREEMENT  
(MERCHANT AGREEMENT IF CREDIT VOUCHER)

Thank you for your payment!

Merchant Copy