


*Gidw.*

PROJECT Phase II SHEET \_\_\_\_\_ OF \_\_\_\_\_  
SUBJECT \_\_\_\_\_ DATE 5-17-18  
JOB NO. 4447  
BY Atlas

330 S. Broadway



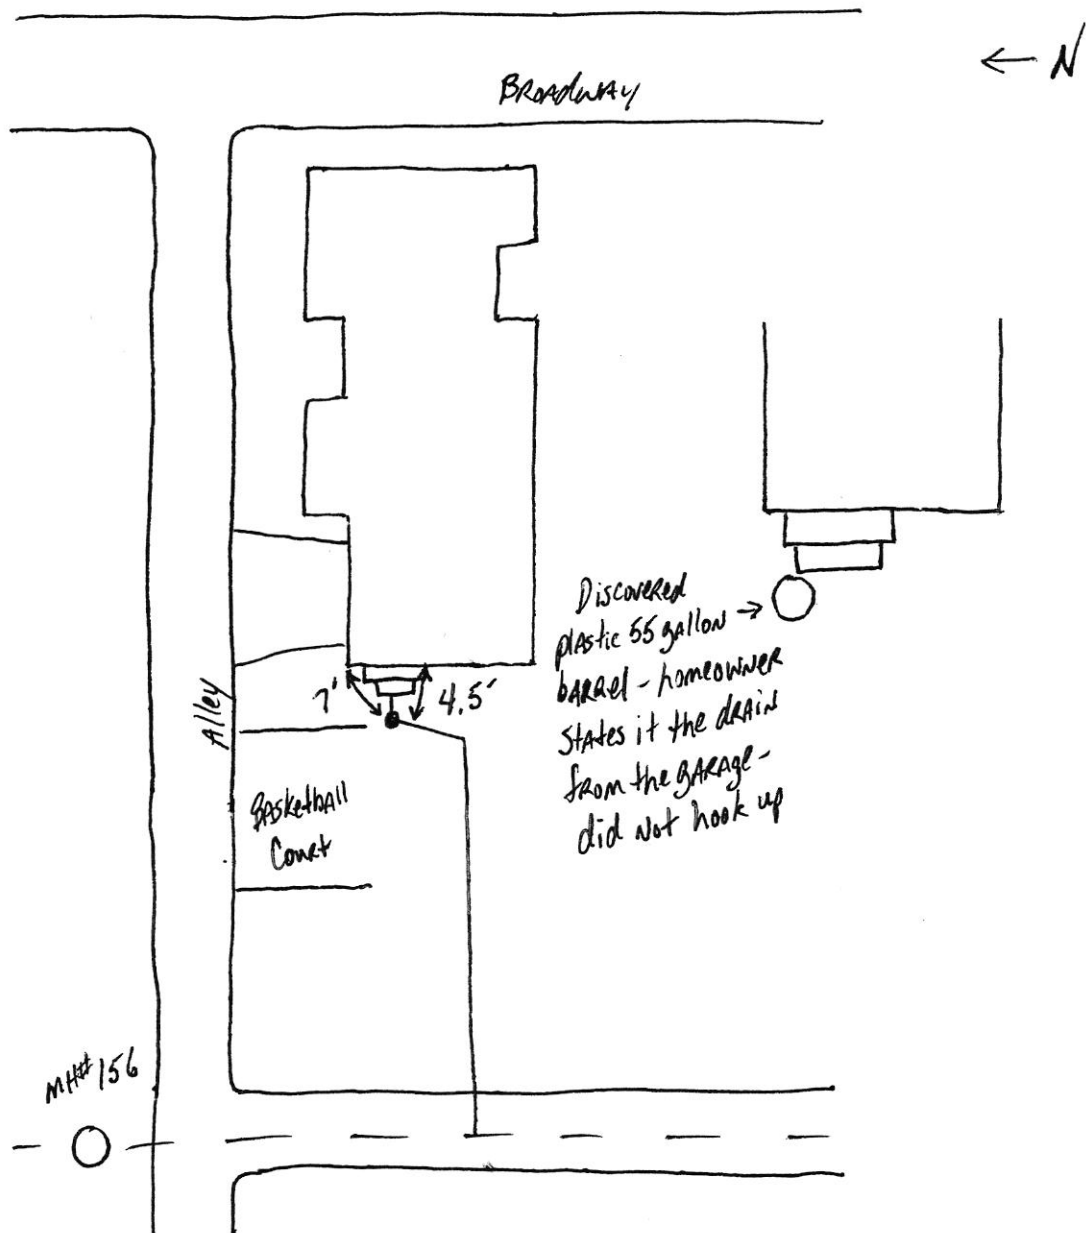

330 S Broadway

Sgt Frost II

5.22.18

