




PROJECT Phase II. SHEET _____ OF _____
SUBJECT _____ DATE 1-10-18
JOB NO. 4447
BY Atlas

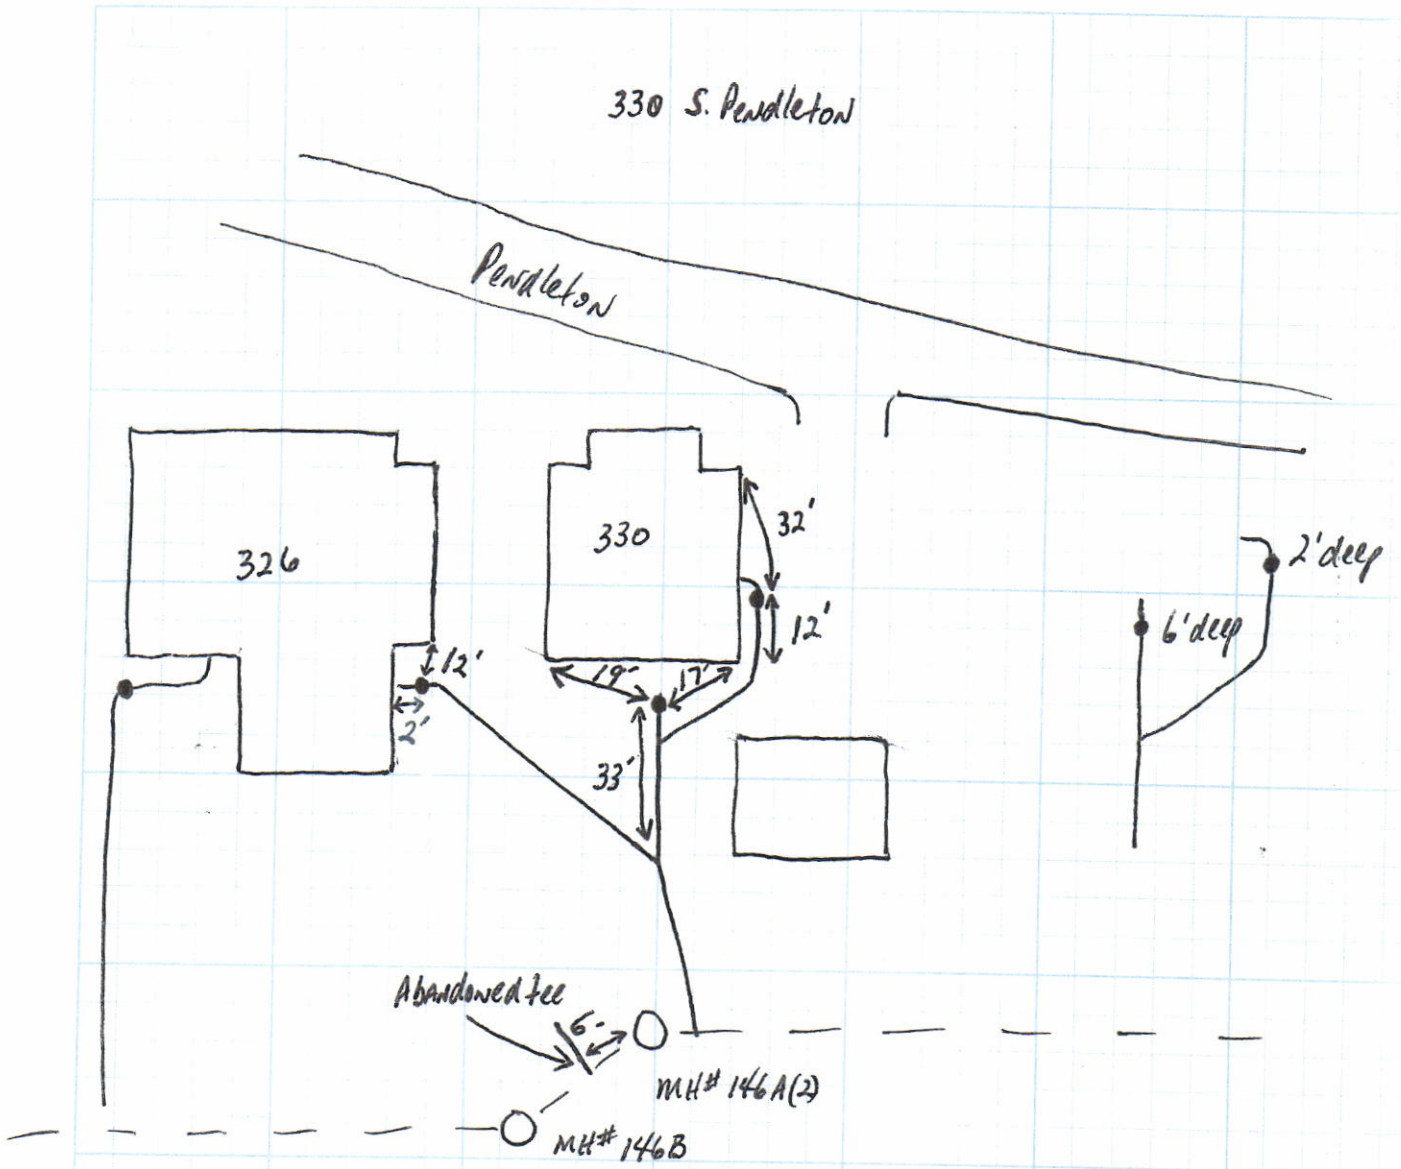

The lateral on the south side of 326 goes into 330

330 S Penickton Ave

SRF Phase II

2018



330 S Pendleton Ave

SRF Phase II

2018

