

GLW

PROJECT

PHASE II

SHEET

OF

SUBJECT

DATE

6-29-18

JOB NO

4447


BY

ATLAS

3289 LICK CREEK PIKE

3310 Angle RD

↑
N

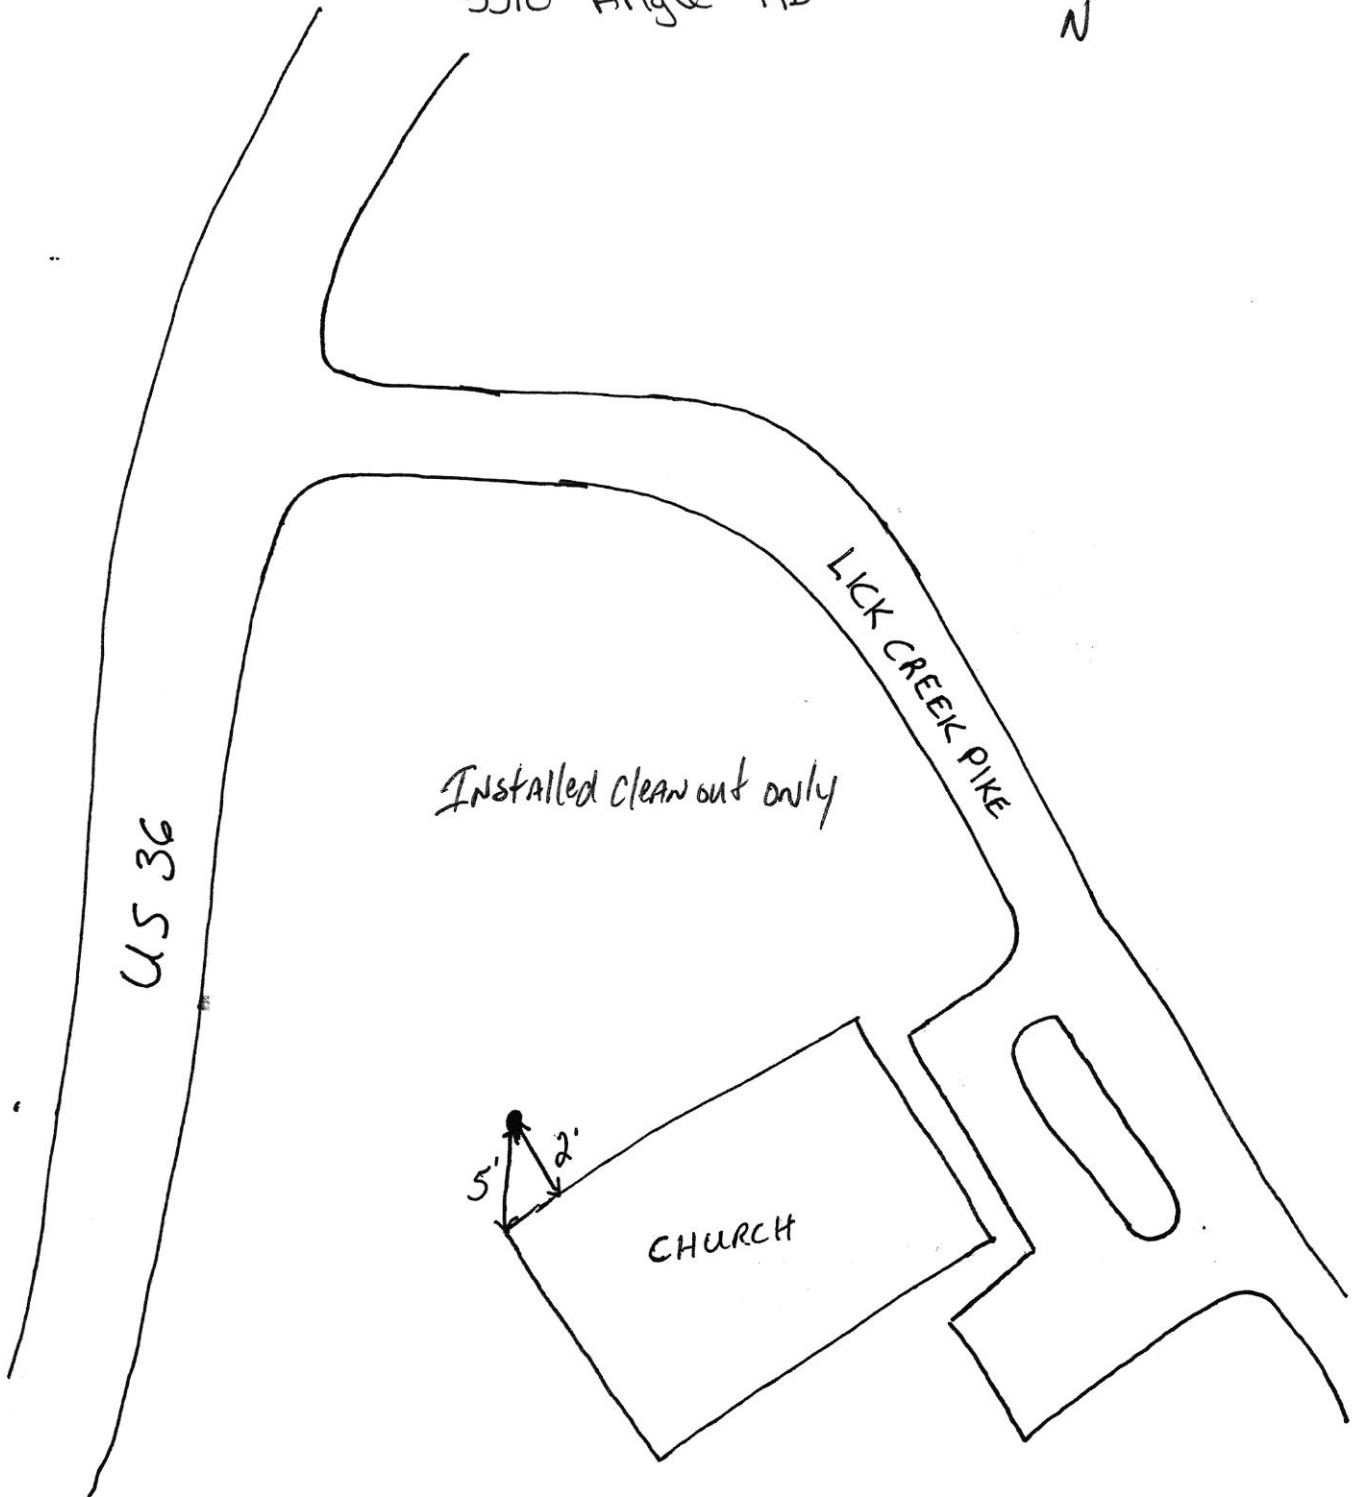

2010 May 23
AKA: 3389

Sgt Phase II

6.29.18

