

Gidw.


PROJECT PHASE II SHEET _____ OF _____

SUBJECT _____ DATE 6-27-18

JOB NO. 4447

BY ATLAS

3319 S.R. 9

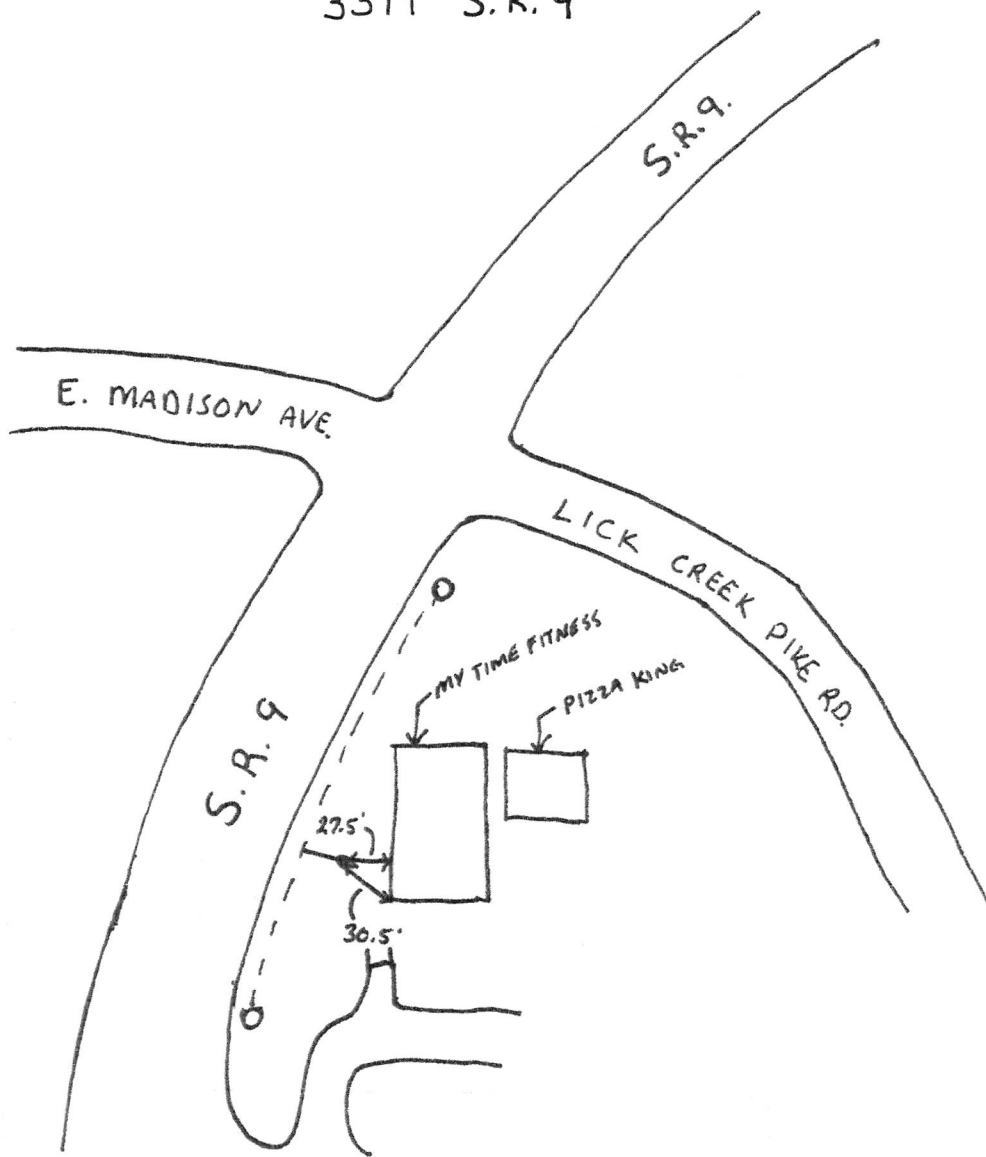

3314 S SR 9

SRE Phase II

7.6.18

