

Gidw.

PROJECT Phase II SHEET _____ OF _____

SUBJECT _____ DATE 5-29-8


JOB NO 4447

BY Atlas

331 S. Pearl

N →

Pearl

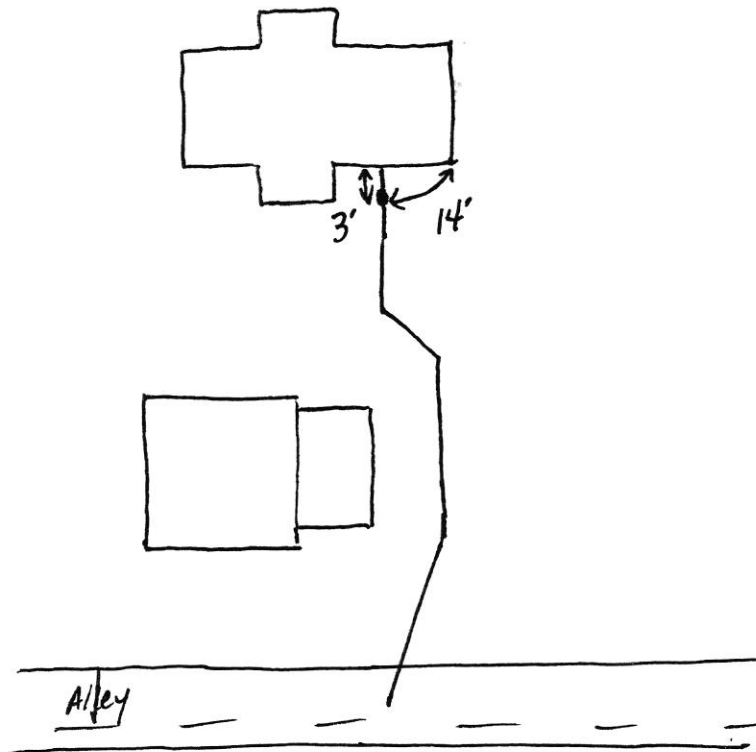

331 S Pearl

SPP Phase II

6-2-18

