

Gidw.

PROJECT Phase II SHEET _____ OF _____


SUBJECT _____ DATE 4-2-18

JOB NO. 4447

BY Atlas

331
311 W. High

laterals for 331-325 High
211 Franklin in the same
trench
325

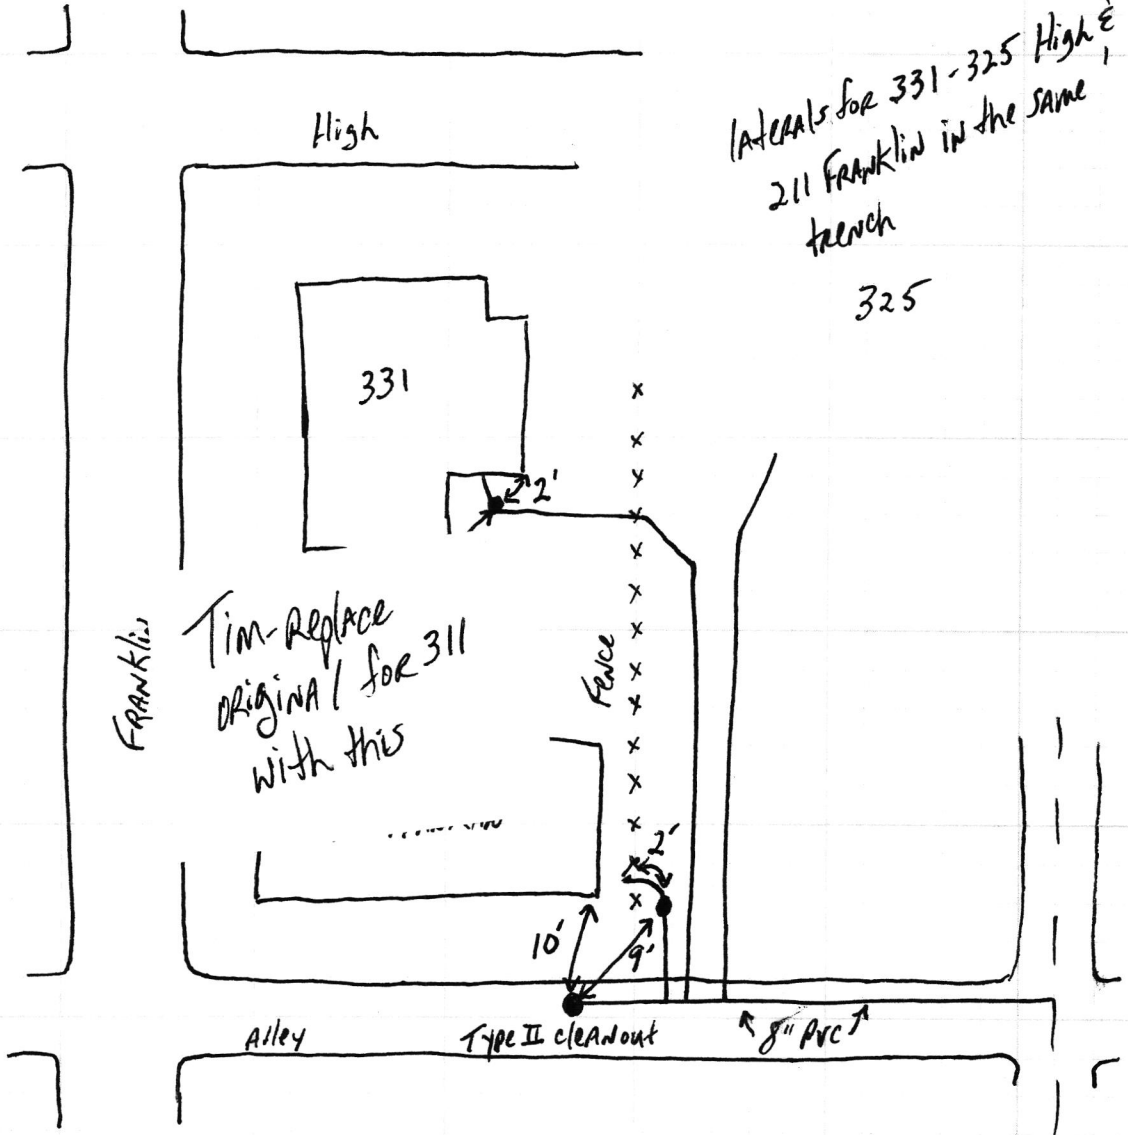

331 High
325 High

OP1 11.000 11

4.9.18



331 High

SRF Phase II



Gidw.

PROJECT Phase II SHEET _____ OF _____
SUBJECT _____ DATE 4-2-18
JOB NO. 4447
BY Alias

