

Gidw.


PROJECT Phase II SHEET _____ OF _____

SUBJECT _____ DATE 5-1-18

JOB NO 4447

BY Atlas

331 - 327 State & 115 Franklin

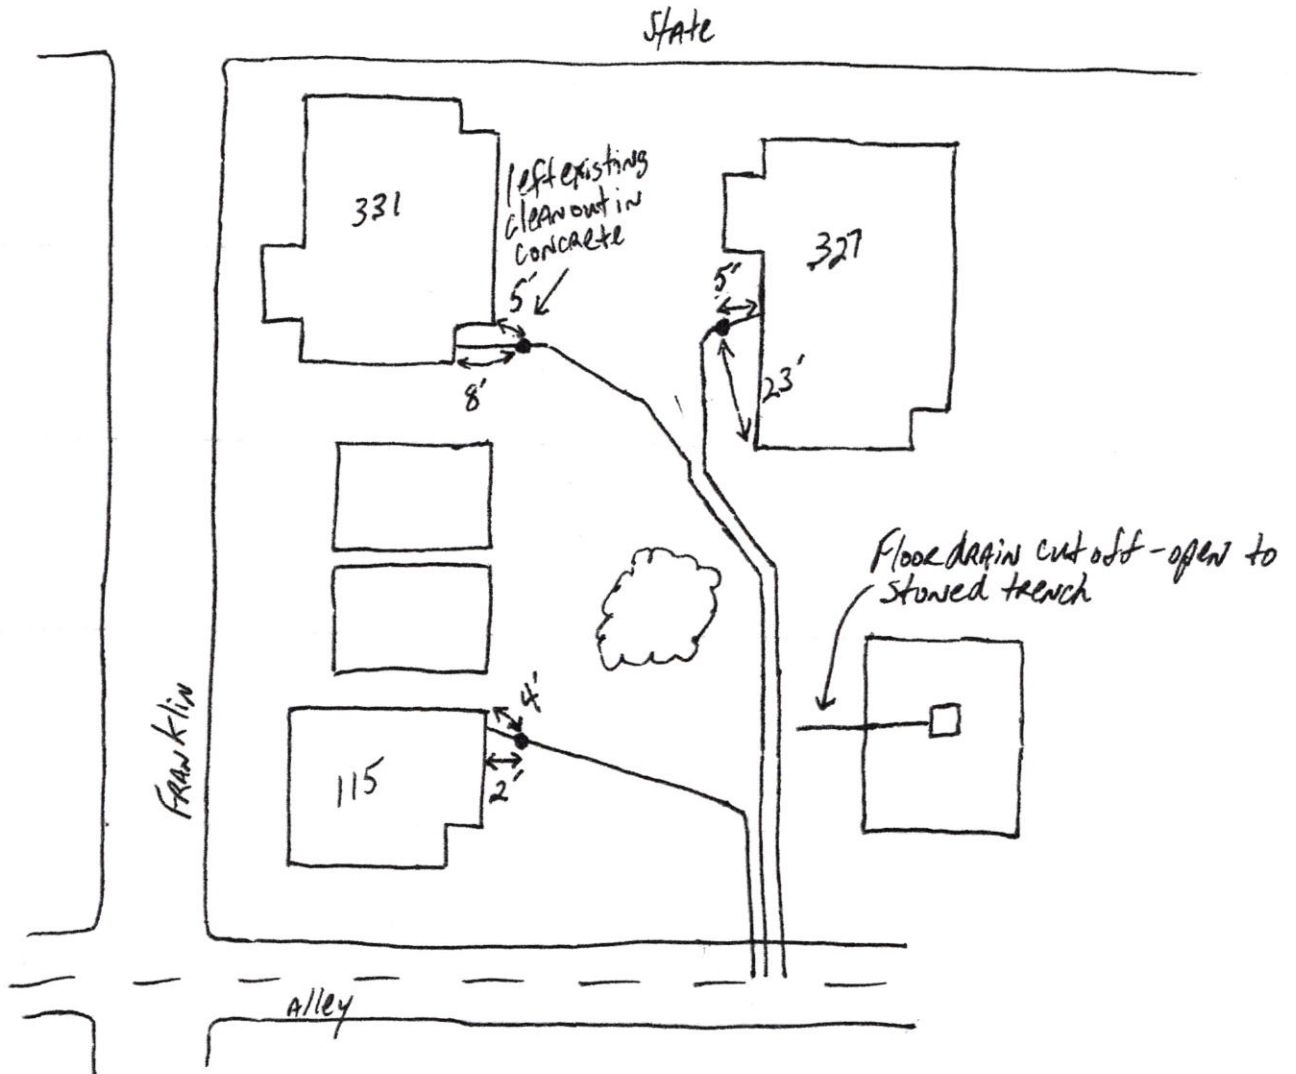

331 W State

SRF
Phase II

5.3.18

