


Gidw.

PROJECT Phase II SHEET _____ OF _____
SUBJECT _____ DATE 5-29-18
JOB NO. 4447
BY ALIAS

332 S. EAST

← N

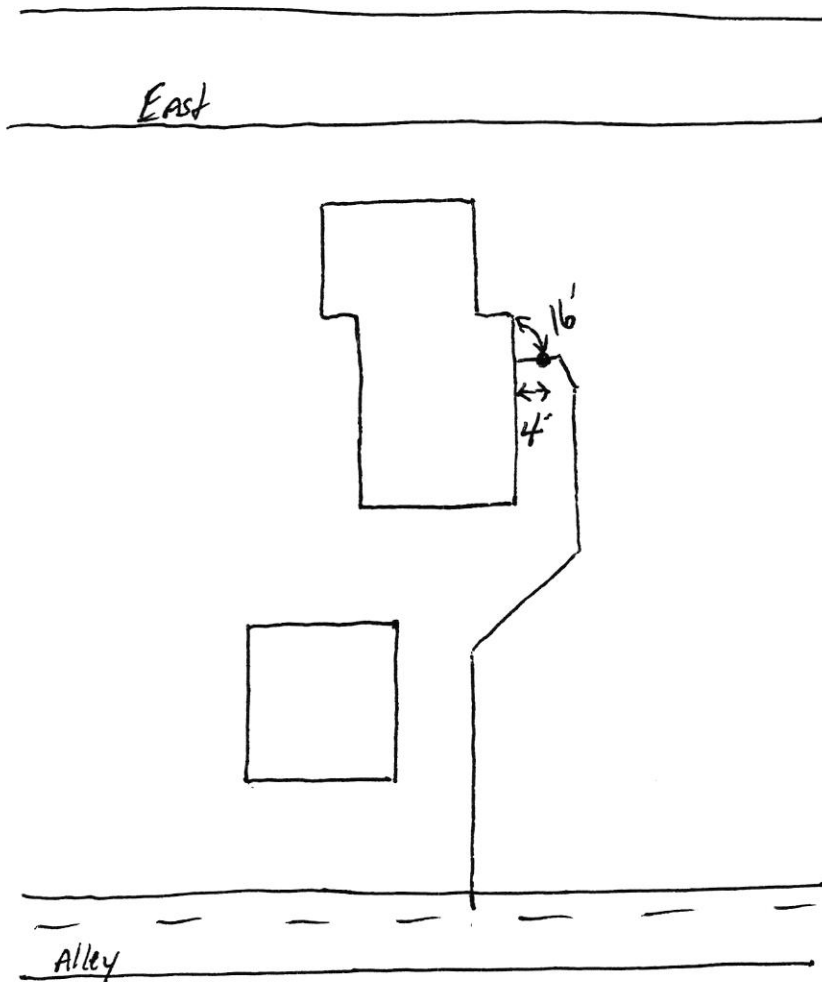

33a S East

SPE Phase II

6.2.18

