

13-30483.00

## FALL CREEK REGIONAL WASTE DISTRICT

No 6103

9378 S 650 WEST, P.O. BOX 59, PENDLETON, IN 46064

765-778-7544

## AGREEMENT FOR SANITARY SEWER SERVICE

Bubalo  
Brett

This Agreement made and entered into this 22 day of September, 2006 between FALL CREEK REGIONAL WASTE DISTRICT ("District") and Conrad Rudge ("Applicant") regarding the provision of sanitary sewer service, and the assignment of capacity in, and connection to, the District's facilities for the premises located at Pines at Deerfield lot 78 333 Tamarack

NOW THEREFORE, the parties, in consideration of the mutual promises set out in this Agreement, the receipt and sufficiency of which is hereby acknowledged, agree as follows:

1. The Applicant agrees that all workmanship and materials shall conform to all District ordinances and the District's construction standards. District must accept and approve all work and materials before backfilling and final connection is made to the sewer mains. Any violation of this provision will cause all lines and appurtenances in violation to be removed and replaced at the Applicant's expense.
2. The District shall have the right to enter upon the Applicant's premises at all reasonable times to inspect, repair, or replace any equipment used in connection with the District's service or which has an impact on said service.
3. The Applicant shall be responsible for all monthly user rates, capacity charges, and tap fees. The failure to pay any rate charge or fee may result in a lien against the property and/or the termination of service to the property, the cost of which will be borne by Applicant, including, but not limited to, all attorney's fees and collection costs.
4. The District shall not be responsible for any damages as a result of any failure to supply service unless said damages are due to default, neglect or culpability on the part of the District.
5. If there is an available sanitary sewer within three hundred (300) feet of the property line, the property owner shall be required to connect to the District's sanitary sewer system.
6. The Applicant and District agree that the provision of sanitary sewer service touches and concerns the property and the terms of this Agreement bind the District and Applicant and their heirs, executors, administrators, personal representatives, successors, agents, attorneys, assigns, designees, and transferees.

The parties hereto have read and fully understand the above provisions and agree to comply with said provisions.

FALL CREEK REGIONAL WASTE DISTRICT  
Rebecca Hunter  
Signature

APPLICANT  
Rebecca A. McClintick  
Signature

STATE OF INDIANA )  
 ) SS:  
COUNTY OF MADISON )

SUBSCRIBED and sworn to before me this 22<sup>nd</sup> day of September, 2006.

My Commission Expires:

Commission Expires May 19, 2008

Signature

Rebecca A. McClintick

Printed

A Resident of  
Madison County, Indiana

Notary Public  
Resident of Madison County



Rebecca A. McClintick, Notary Public

INSPECTOR SN DATE INSPECTED 9/22/06 APPROVED ✓ REJECTED \_\_\_\_\_

REASON FOR REJECTION \_\_\_\_\_

DATE REINSPECTED \_\_\_\_\_ APPROVED \_\_\_\_\_ REJECTED \_\_\_\_\_

NOTES:

SIZE PIPE 6" TYPE PIPE 35

BASEMENT YES \_\_\_\_\_ NO \_\_\_\_\_

SUMP PUMP YES \_\_\_\_\_ NO \_\_\_\_\_

DOWNSPOUT TO GROUND YES \_\_\_\_\_ NO \_\_\_\_\_


SEPTIC TANK PUMPED & FILLED YES \_\_\_\_\_ NO \_\_\_\_\_

CONTRACTOR Accurate EX

SPECIAL CONDITIONS \_\_\_\_\_

EXISTING HOME \_\_\_\_\_

NEW CONSTRUCTION ✓

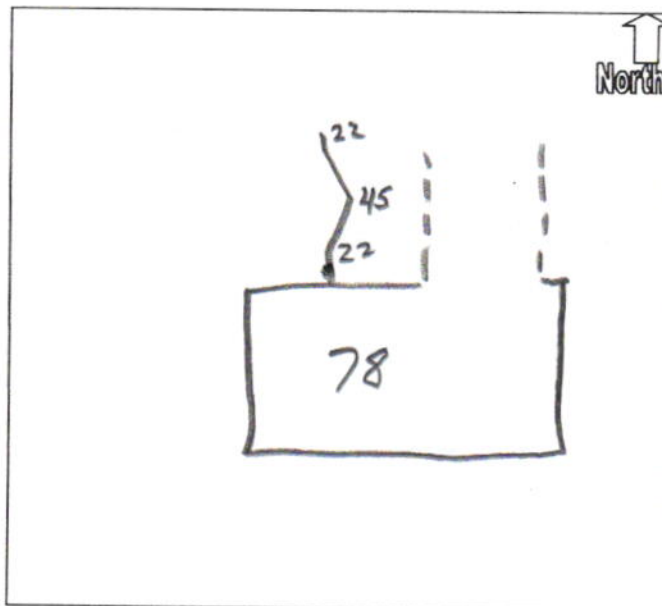

CORONADO RIDGE DEVELOPMENT CORP.

P.O. BOX 647  
WESTFIELD, IN 46074  
PH. 317-867-1929

OLD NATIONAL BANK  
INDIANAPOLIS, INDIANA  
oldnational.com  
71-1/863

008053

9-22-06

PAY TO THE  
ORDER OF

Fall Creek R.W.D.

\$ 10,540 -

Ten Thousand Five hundred forty dollars + 00/100

DOLLARS

Valerie Bellon

MEMO Tap Fee's 54,68.78 + 87 Pines

⑈008053⑈ ⑆086300012⑆