

Gidw.

PROJECT Phase II SHEET _____ OF _____


SUBJECT _____ DATE _____

JOB NO. 4447

BY ALAS

335 S. Pearl

N →

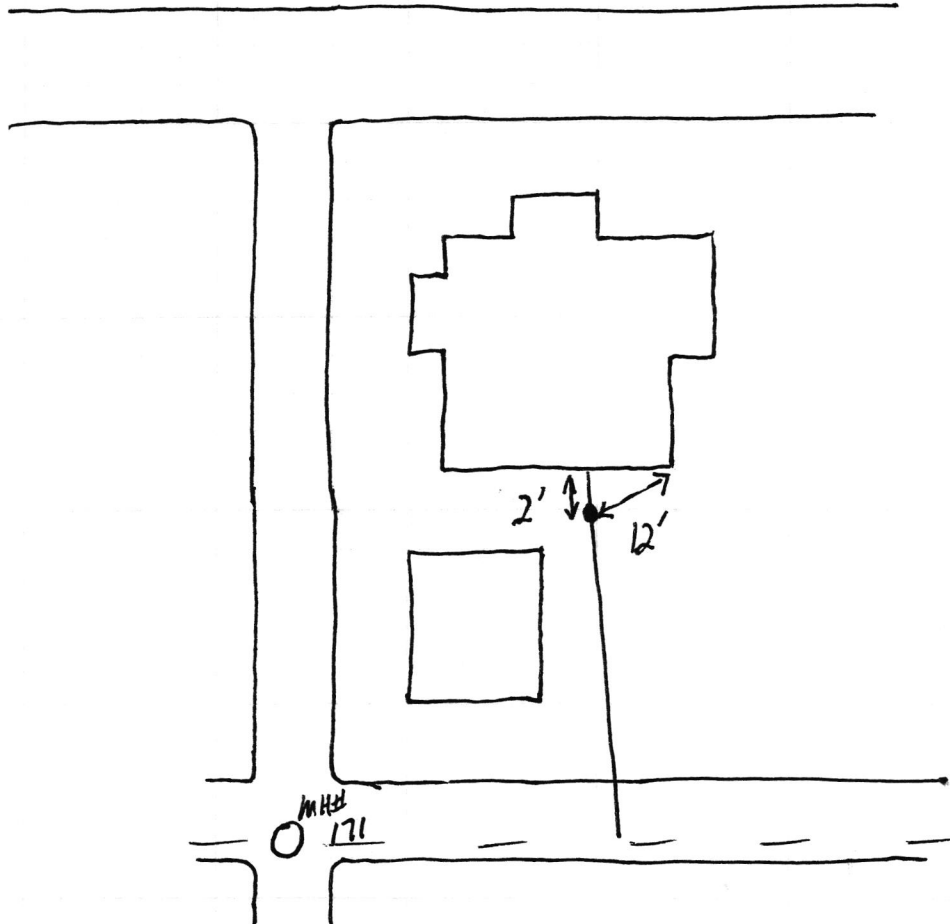

335 S Pearl

SAC Phase II

6.11.18

