

Gidw.

PROJECT Phase II SHEET _____ OF _____

SUBJECT _____ DATE 7-26-18



JOB NO. 4447

BY A+As

338 S. Pearl

← N

Pearl

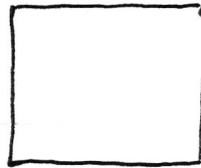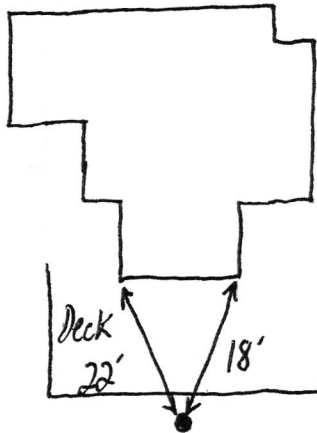

Alley

○
MH#
169

338 Pearl

SRF Phase II

7.30.18

