

Gidw.

PROJECT Phase II

SUBJECT _____



SHEET _____ OF _____

DATE 12-14-17

JOB NO. 4447

BY Atlas


338 S. Pendleton Apts.

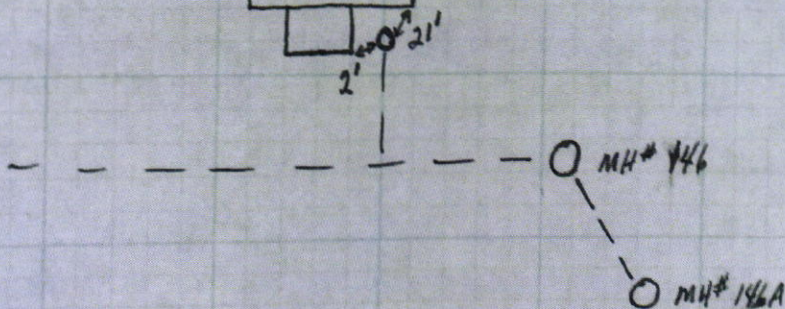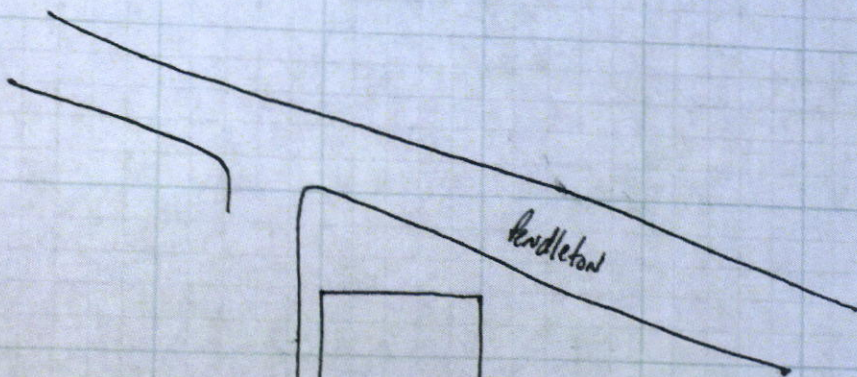

338 S Pendleton Ave
Apartments

Lateral replacement

SRF Phase II
Dec '17

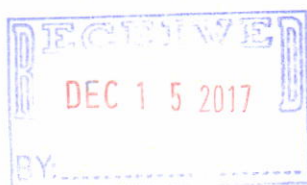

338 S Pendleton Ave
Apartments

Lateral replacement

SRF Phase II
Dec '17

