

Gidw.

PROJECT Phase II SHEET _____ OF _____

SUBJECT _____ DATE 7-27-18



JOB NO. 4447

BY Atlas

339 S. Broadway

N →

Broadway

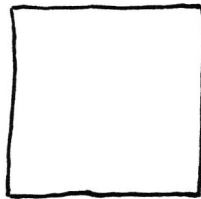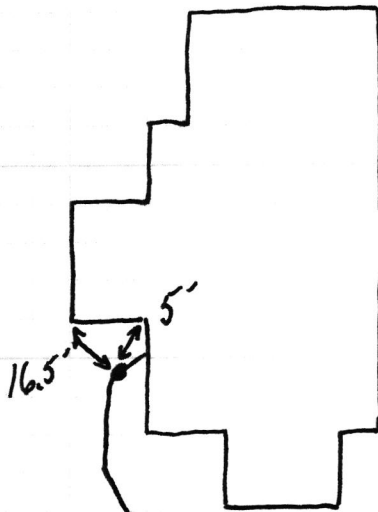

○ MH # 169

Alley

339 S Broadway

SRF Phase II

7.30.18

